


T.36S., R.6W., W.M.

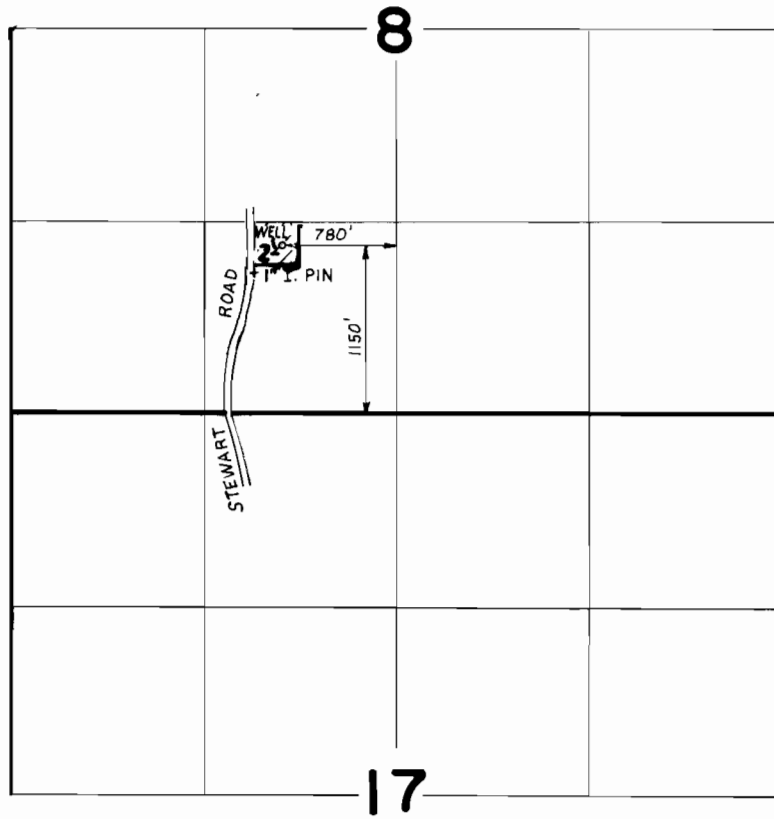

SCALE: 4" = 1 MILE



FINAL PROOF SURVEY
UNDER

Application No. G-10305 Permit No. G-9331.....
IN NAME OF

.....BURTON B. & PATRICIA A. ANSLYN.....

Surveyed JAN. 17 1984, by B. S. JAMES.....