T. 4S., R. 1W., W.M.

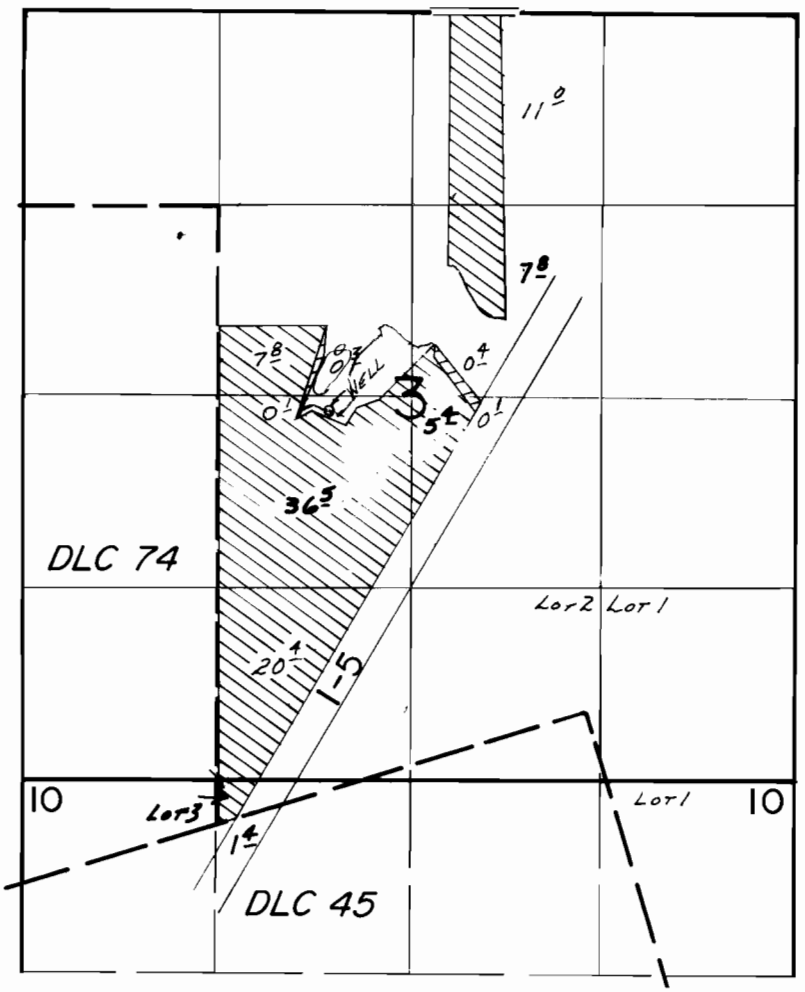

WELL LOC.: 2850' N. & 750' E. FROM SW COR. LOT 3, SECTION 10

PRIMARY

SUPPLEMENTAL

FINAL PROOF SURVEY

UNDER

Application No. G-10361 Permit No. G-9394

IN NAME OF

NICHOLAS & NATALIE DUBENKO

Surveyed Sept. 8 1983, by L. M. TOLL

DEN-111-61 BWB