



T. 3N., R. 28E., W. M.

G-10292
75422
64441
75132

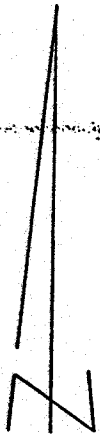

SCALE 1" = 1320'

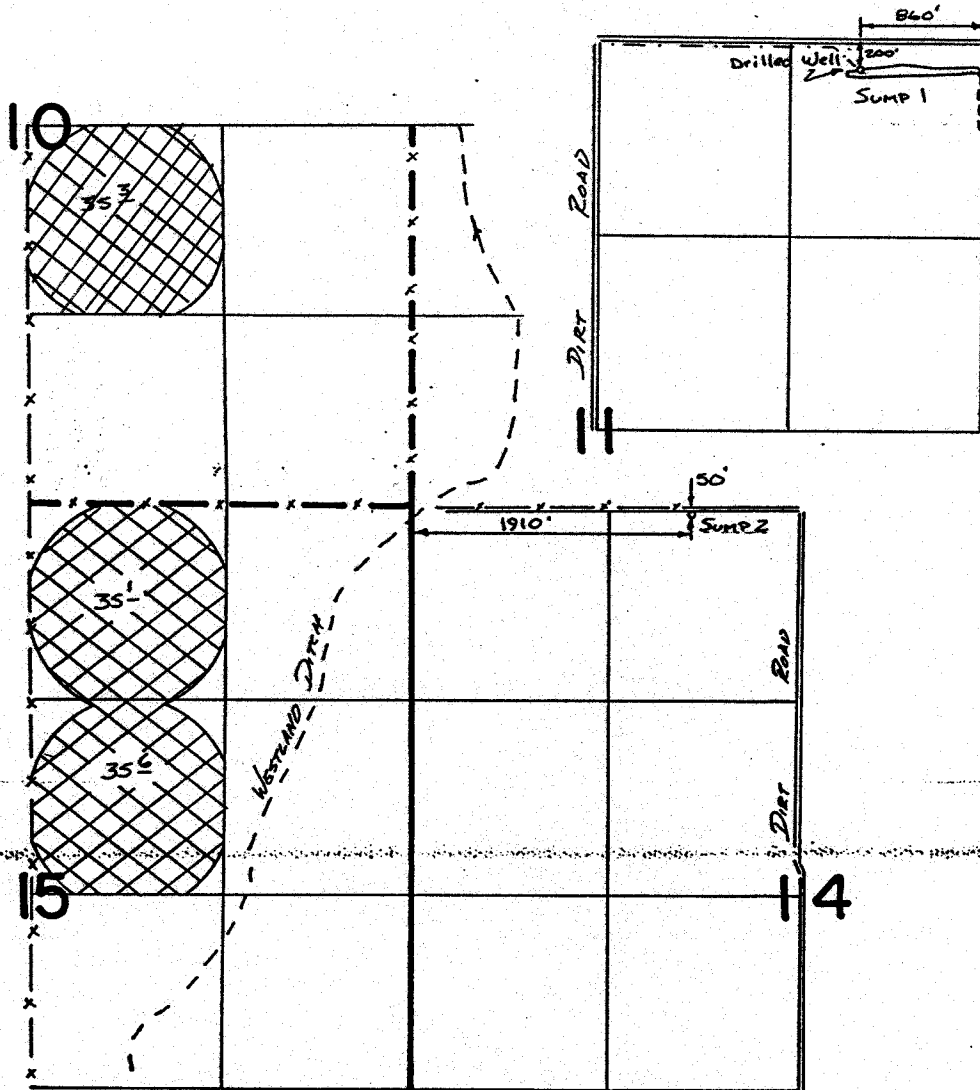

SUPPL



PRIM

FINAL PROOF SURVEY UNDER

Application No. G:11182 Permit No. G:10292
IN NAME OF

.....JOHN N. CORREA.....

Surveyed 8:5..... 1987, by V.L. Church.....