




T.15 S., R.14 E., W.M.

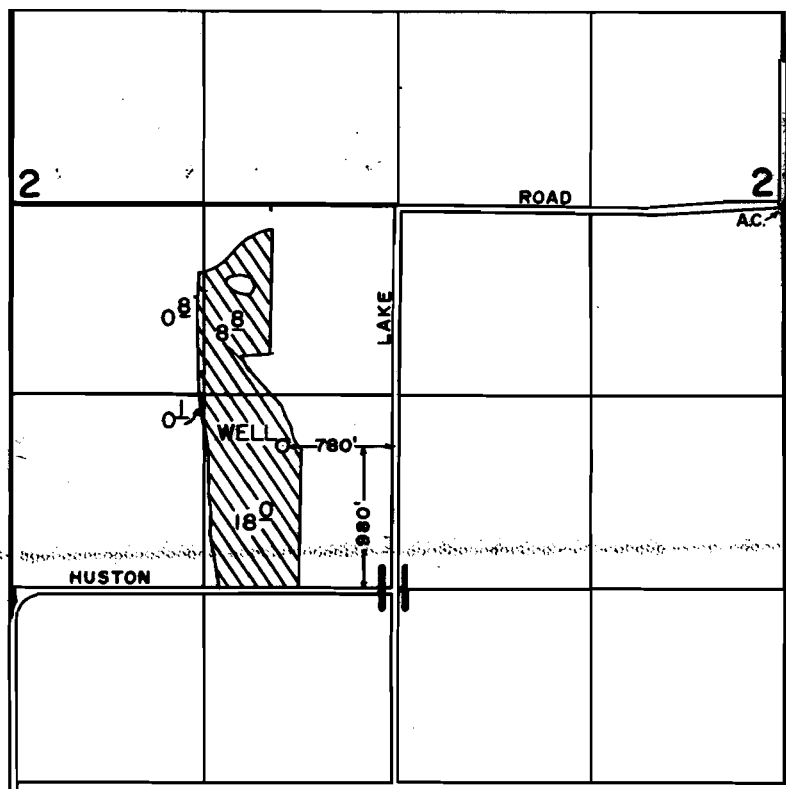

SCALE: 1" = 1320'

FINAL PROOF SURVEY
UNDER

Application No. G-11319 Permit No. G-10447
IN NAME OF

cert # 64442

KEITH & NANCY KNOCHE

Surveyed JULY 5, 1989, by B. W. BISHOP