


T.15S., R.5W., W.M.

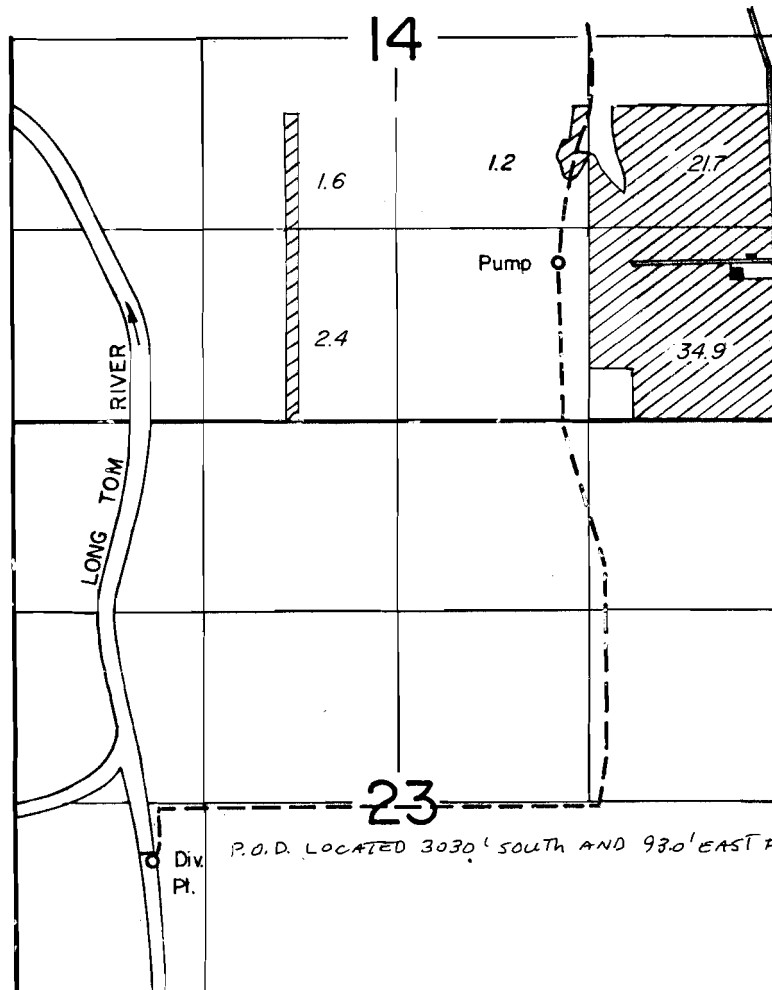

FINAL PROOF SURVEY
UNDER

Application No. 44682, Permit No. 33453
IN NAME OF

CHAUNCEY M. HUBBARD

Surveyed MAY 8, 1980, by *[Signature]*