T.6&7S.,R.4W.,W.M.

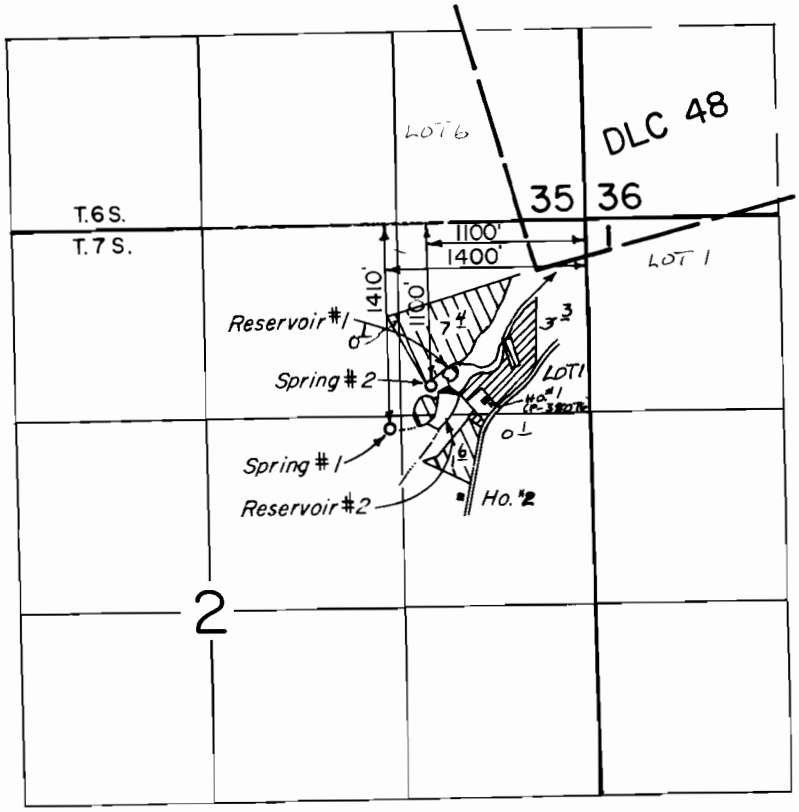

Reservoirs Located: #1 - 1000' S. & 920' W.; #2 - 1170' S. & 960' W.; both from the NE corner Section 2

FINAL PROOF SURVEY

UNDER

TRANSFER NO. 2781

R-47400 R-6157

47937 38076

Application No. 55224 **Permit No.** 41617

IN NAME OF

W. J. KVARSTEN

Surveyed NOV. 4, 1981, **by** [illegible]

Revised: 4-27-90 [illegible]

DFP-2LL-181, DFP-2D-36, PTS-1981-B