
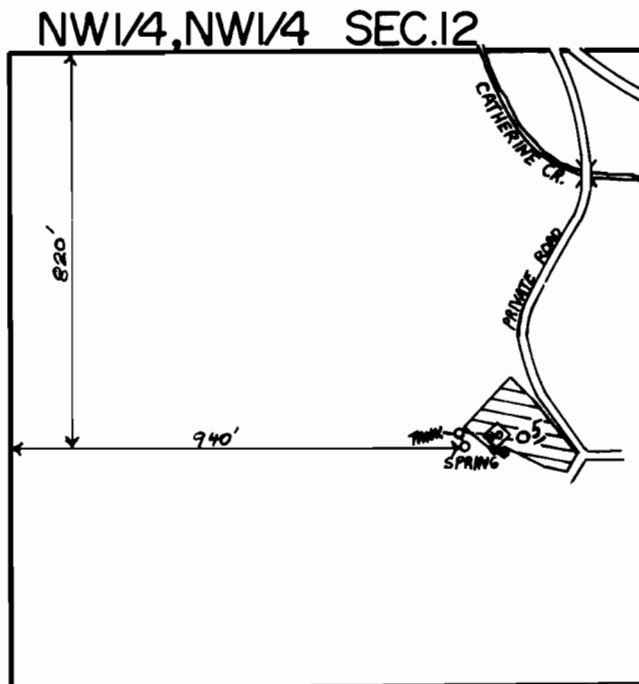


T. 5 S., R. 40 E., W.M.

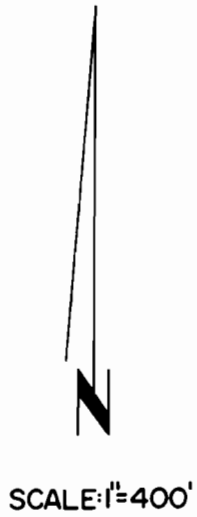

FINAL PROOF SURVEY UNDER

Application No. 49322 Permit No. 37280.....
IN NAME OF

.....DONNA LEE GROCE.....

Surveyed July 16..... 1985, by V.L. CHURCH.....