


T.26S.,R.8W.,W.M.

Section 1

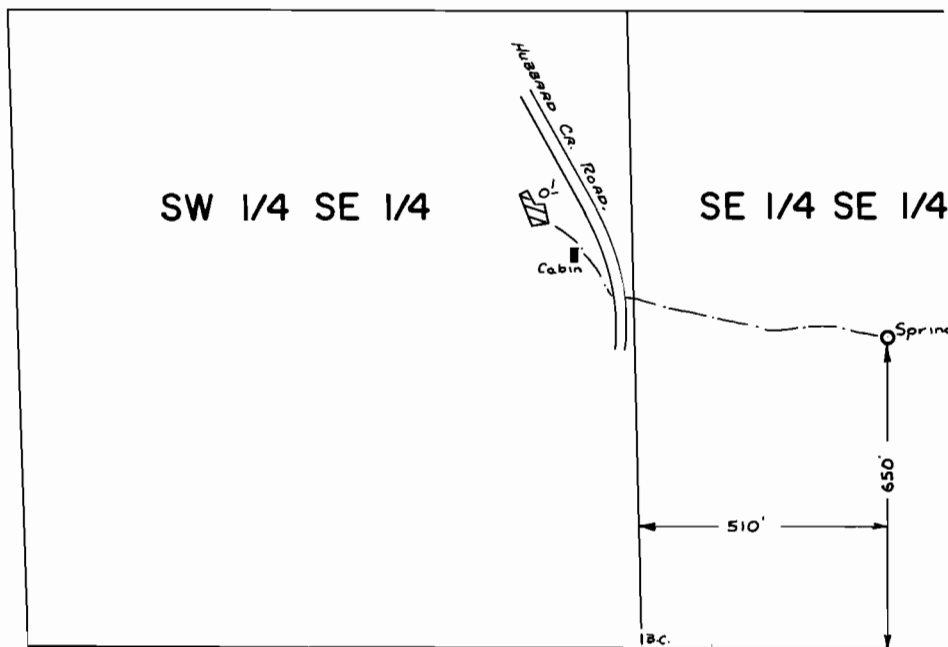

SCALE : 1" = 400'

FINAL PROOF SURVEY
UNDER

Application No. 50517 38145
58596 Permit No. 44240
IN NAME OF

RALPH & CATHY BURT, JR.

Surveyed June 22 1982, by L. M. TOLL