
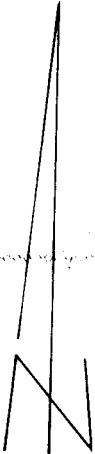


R-6209  
64451

T. 6S., R. 26E., W. M.

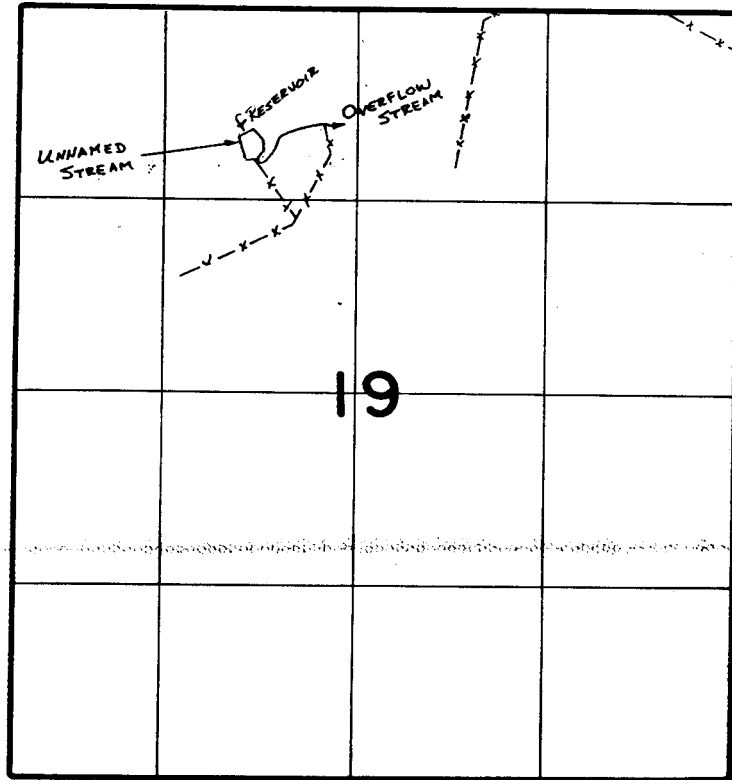

SCALE 1" = 1320'

**FINAL PROOF SURVEY**  
UNDER

Application No. **R:51161**. Permit No. **R:6209**.  
IN NAME OF

**KINZUA CORPATION**

Surveyed *11-4* 1987, by *V.L. Church*

PTS ENCLOSED

VLC