


T. 24 S., R. 5 W., W.M.

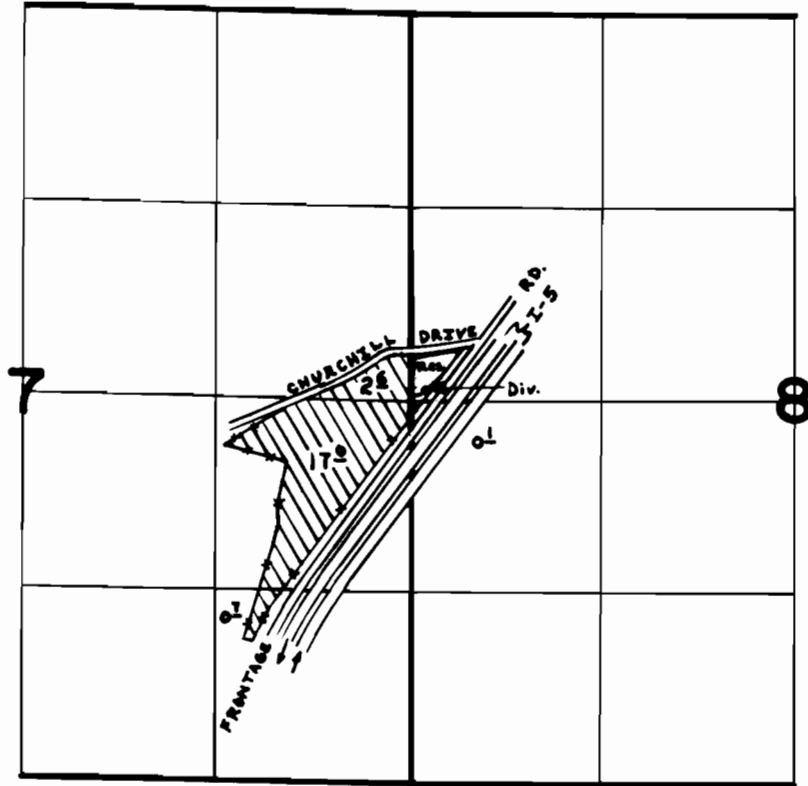

DIV. PT. LOCATED: 75' N. & 100' E. FROM W. 1/4 COR. SEC. 8

FINAL PROOF SURVEY UNDER

R-51194

R-6211

Application No. 51195 Permit No. 38684
IN NAME OF

PAUL & JOHANNA SYPHUS

Surveyed MAY 23 1978, by D.W. SPARKS