


T.2S.,R.12E., W.M.

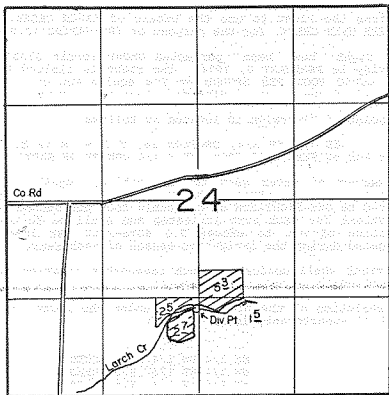

Div Pt Loc 1150' N & 50' W From The S1/4 Corner Of Section 24

SCALE: 1"=1320'

FINAL PROOF SURVEY
UNDER

Application No. 51453... Permit No. 37333.....
IN NAME OF

H. E. DRISKEL.....

Surveyed APRIL 18, 1982, by J. K. KEMP.....