


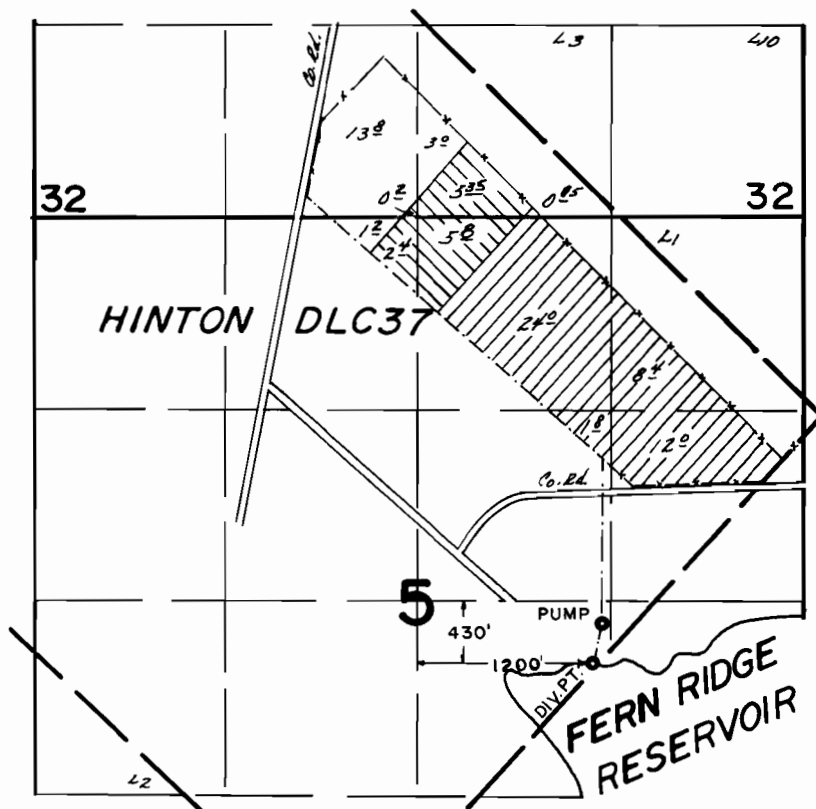

T.16&17S. R.5W.W.M.



FINAL PROOF SURVEY UNDER

Application No. **51683** 48830. Permit No. **38969** 36944. →  → 
IN NAME OF

.....**DAVID N. & ALICE L. BURKS**.....

Surveyed **May 15** 1979, by **S.C. BROWN**.....