


T.19S., R. 43E., W.M.

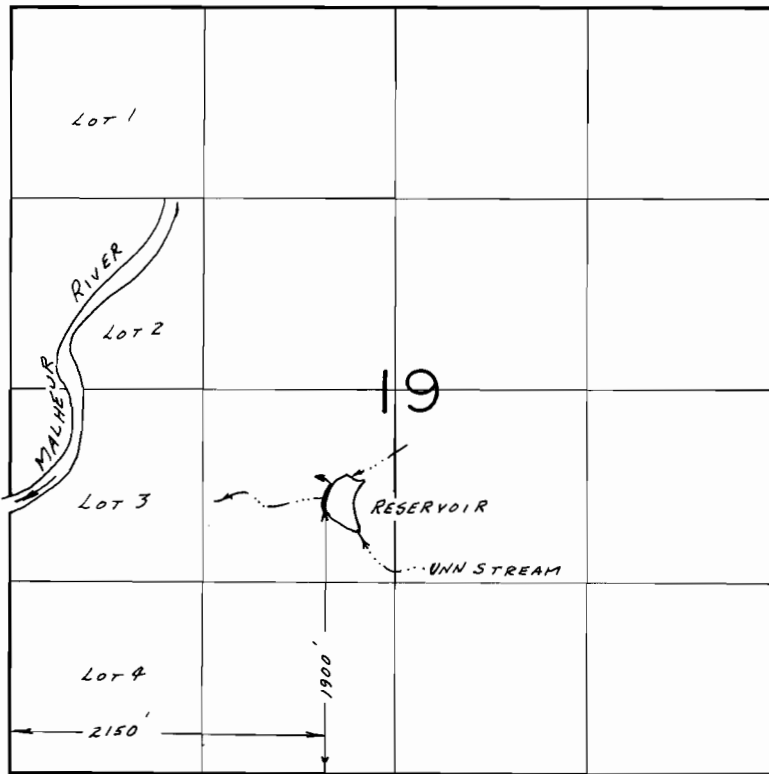

SCALE: 1"=1320'

FINAL PROOF SURVEY
UNDER

Application No. R-51849 Permit No. R-6745....
IN NAME OF

.....GLENN C. HERMAN.....

Surveyed May. 8..... 19.86, by L. M. TOLL.....