


T. 41 S., R. 8 W., W. M.

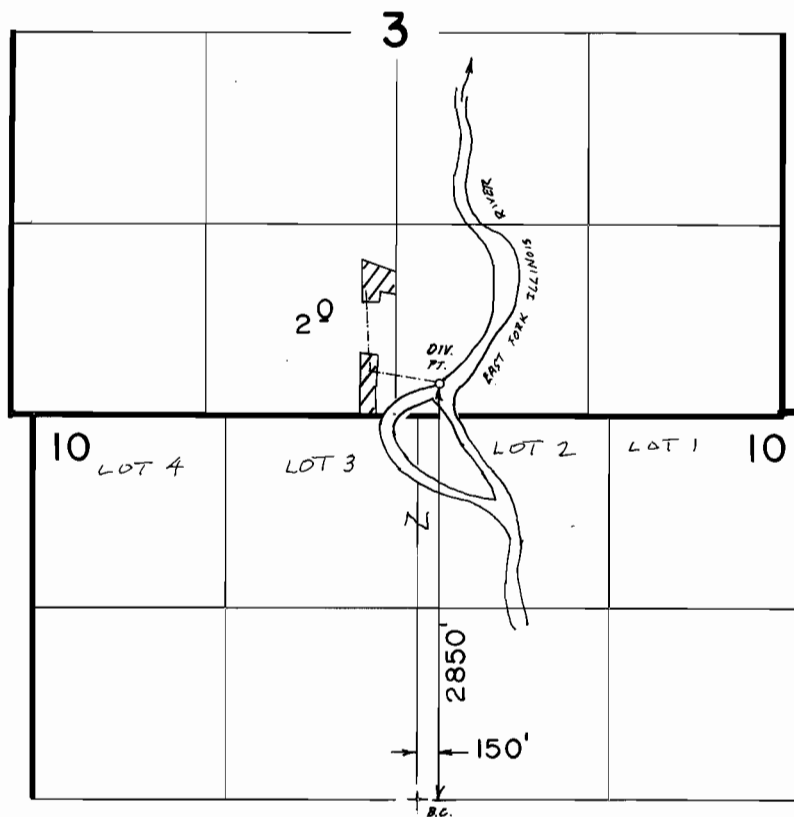

Scale: 1" = 1320'

FINAL PROOF SURVEY UNDER

Application No. 51900 Permit No. 37522
IN NAME OF

RONALD J. THATCHER

Surveyed APR. 8 1986, by B. S. JAMES