


T. 29S., R. 5W., W.M.

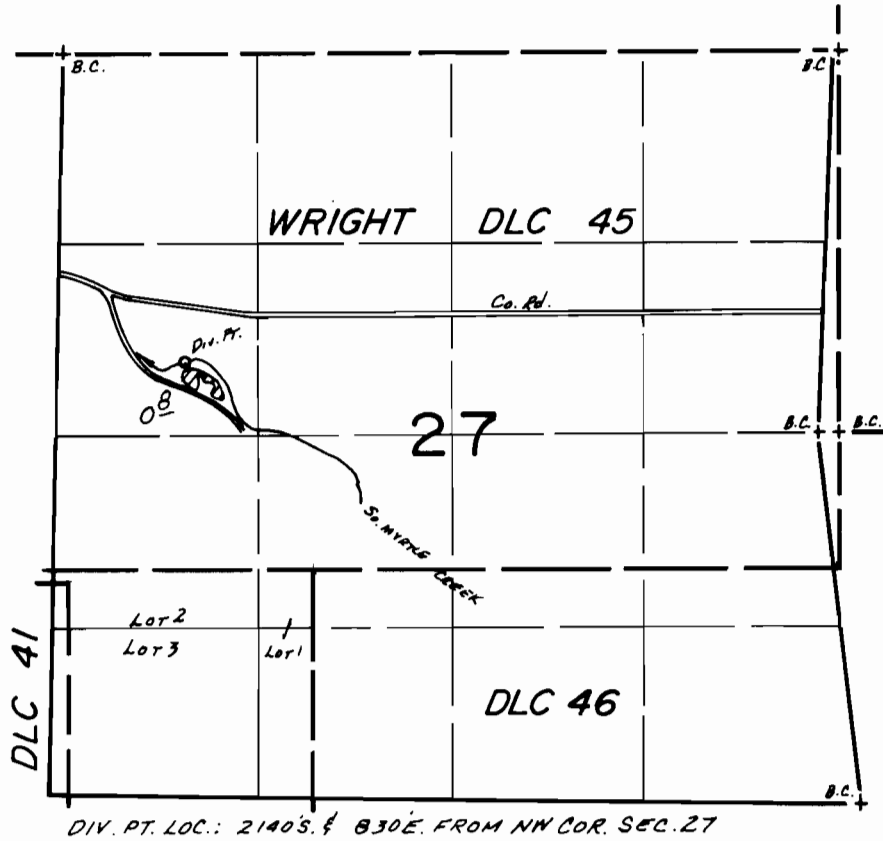

**FINAL PROOF SURVEY**  
UNDER

Application No. 52065.. Permit No. 39236.....  
IN NAME OF

.....LILLIAN McANALLY.....

Surveyed JUNE 11.. 1987., by J.S. DONALDSON