


T. 6N., R. 6W., W.M.

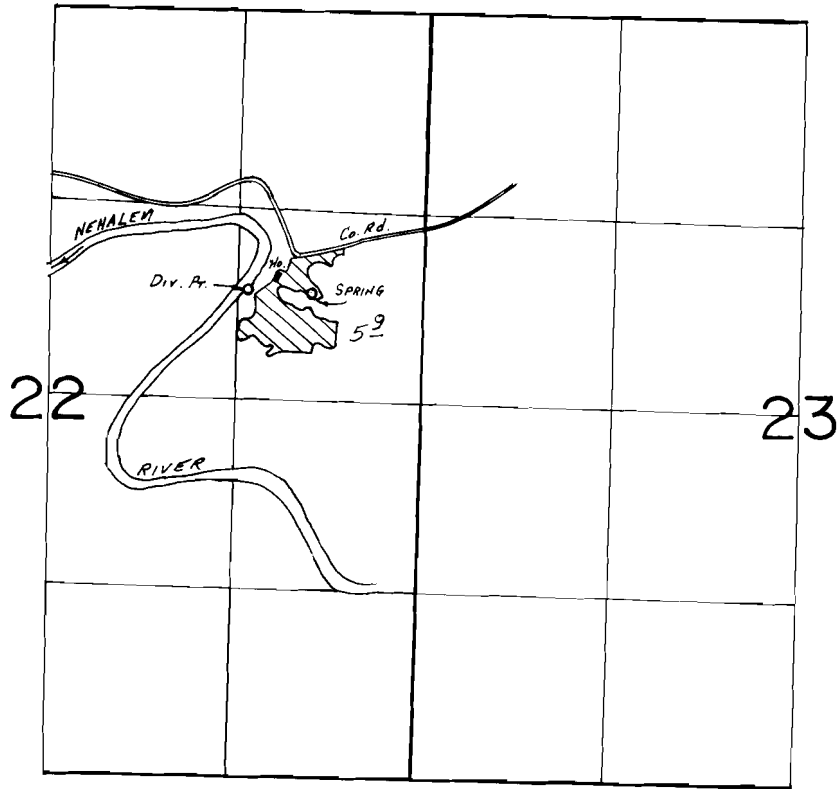

DIV. PTS. LOC: RIVER- 800' N. & 1190' W., SPRING- 770' N. & 750' W., BOTH FROM E. 1/4 COR. SEC. 22.

SCALE: 1" = 1320'

**FINAL PROOF SURVEY**  
UNDER

52902                      39921  
Application No. 58922.. Permit No. 44554.....  
IN NAME OF

.....WALTER S. HERSHEY.....

Surveyed July 11... 19.84, by B.W. BISHOP.....