


T.35S.,R.14W.,W.M.

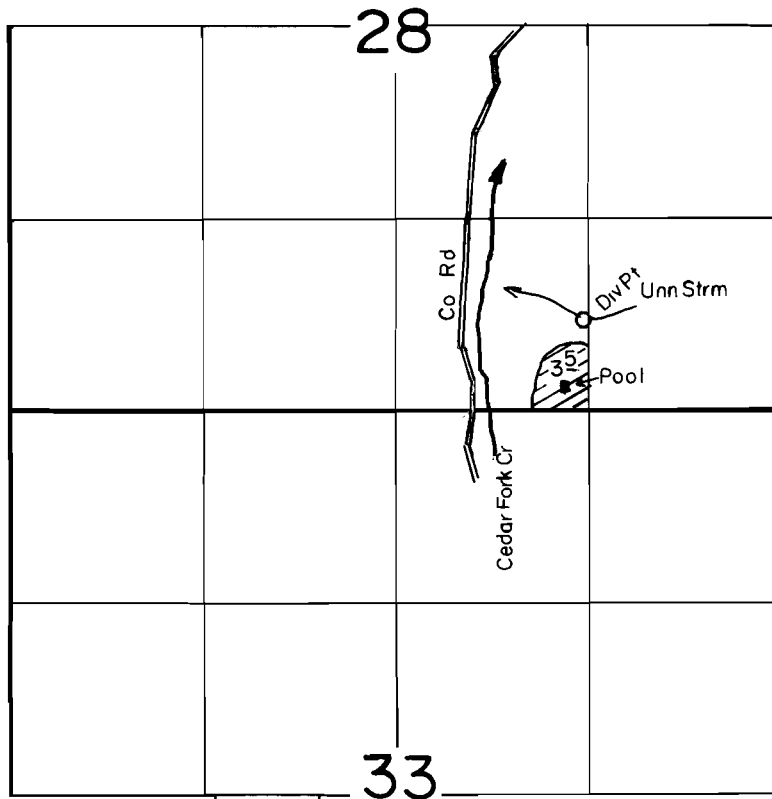

Div Pt Located 600' N & 1260' E From The S1/4 Corner Of Section 28

SCALE: 1"=1320'

FINAL PROOF SURVEY **UNDER**

Application No. 54383.... Permit No. 40799.....
IN NAME OF

.....**ERIC & LOUISE**.....**HALL**.....

Surveyed JULY.22.... 1988., by B.S. JAMES.....