


T. 40 S., R. 14 W., W.M.

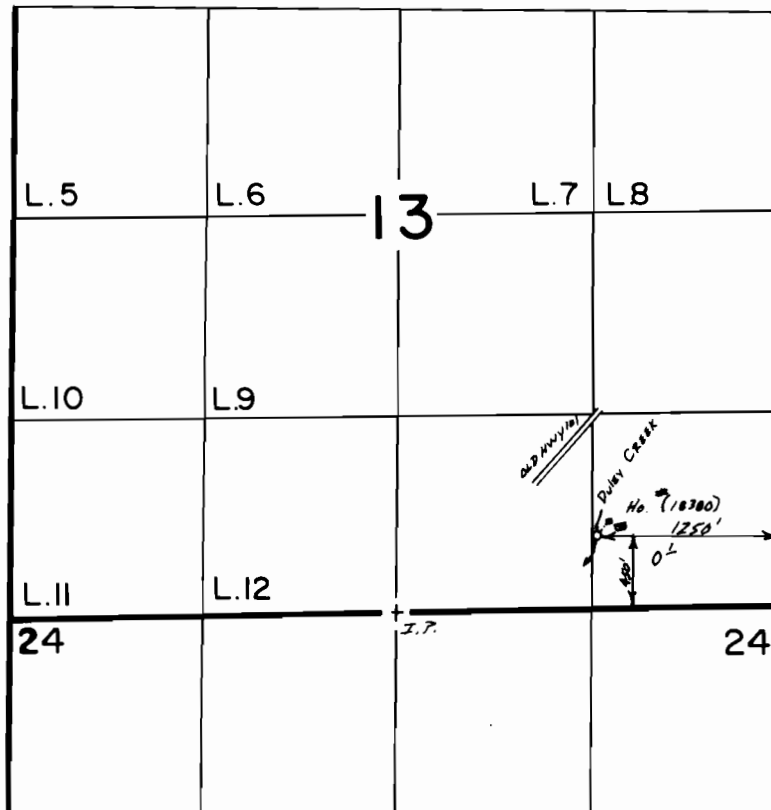

Scale: 1" = 1320'

# FINAL PROOF SURVEY

UNDER

Application No. 54568. Permit No. 40947....  
IN NAME OF

WILLIAM &/or THELMA CANET

Surveyed Sept. 30, 1987, by B.S. JAMES.....