


T.28S.,R.13W.,W.M.

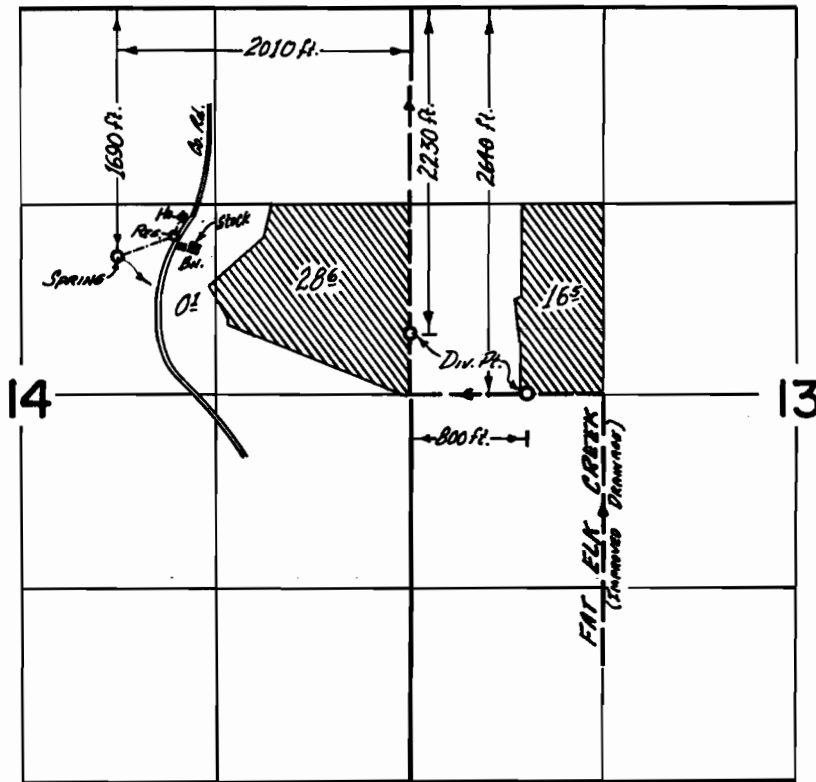

**FINAL PROOF SURVEY**  
UNDER

Application No. 42343 Permit No. 31723  
IN NAME OF

ALDO U. & ROSE MARCA

Surveyed 18 JULY 1972, by L. E. GOULD