


T. 40S., R. 14 W., W.M.

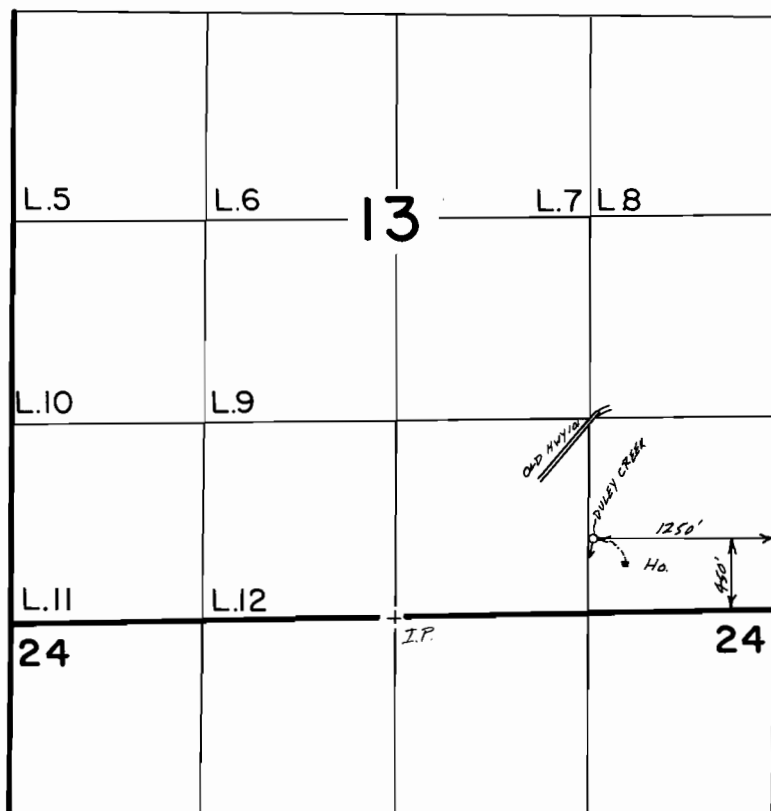

Scale 1"=1320'

FINAL PROOF SURVEY UNDER

Application No. 54978 Permit No. 41577.....
IN NAME OF

WILLIAM & THELMA CANET.....

Surveyed Sept. 30, 1987, by B.S. JAMES.....