


T.7S. R.1W., W.M.

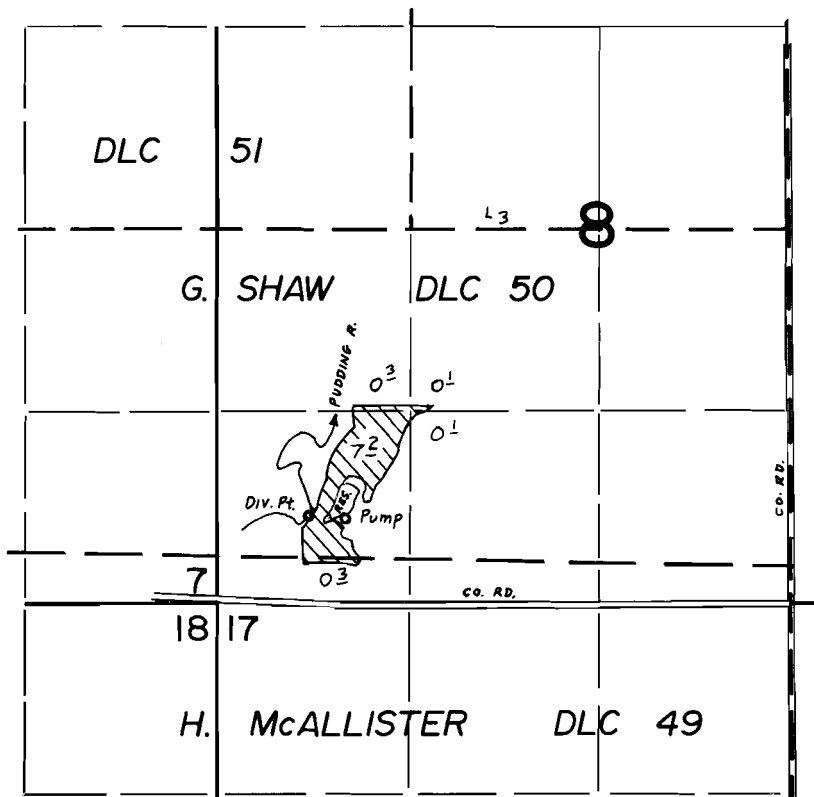

Div. Pt. Loc. 360' N. & 3320' W. From S.E. Cor. DLC 50
 Pump Loc. 340' N. & 3070' W. From S.E. Cor. DLC 50

FINAL PROOF SURVEY UNDER

Application No. 55334... Permit No. 43297.....
 IN NAME OF

.....BENJAMIN KAUFMAN.....

Surveyed MAY 31... 1979., by L.H. NUNN.....