


T. 35S., R. 14W., W. M.

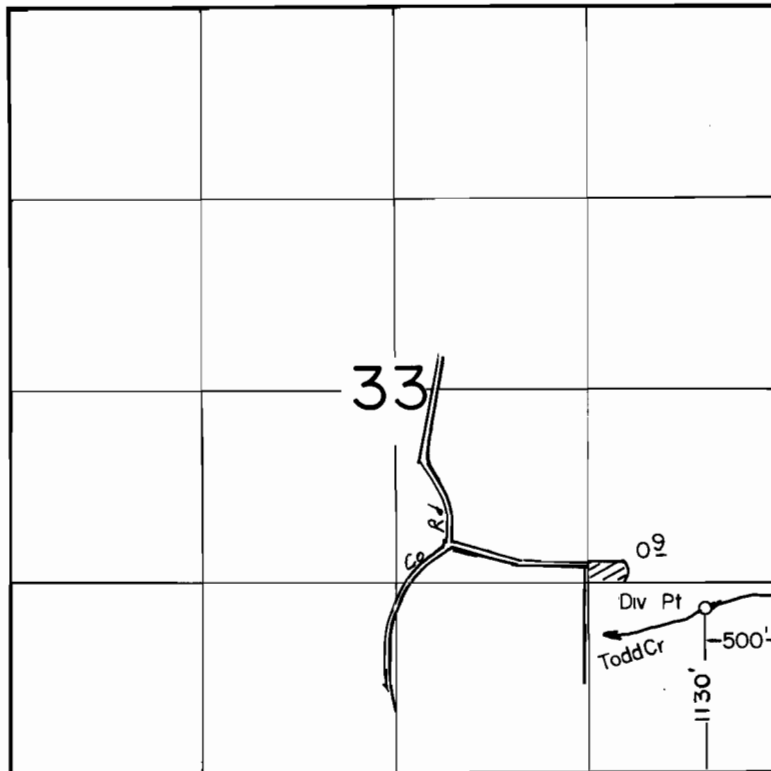

SCALE: 1"=1320'

FINAL PROOF SURVEY UNDER

Application No. 55497..... Permit No. 42088.....
IN NAME OF

..ESTATE OF MARGARET J. TODD.....

Surveyed JULY 25... 1988.., by ..B. S. JAMES.....