


T. 9&10S., R. 3E., W.M.

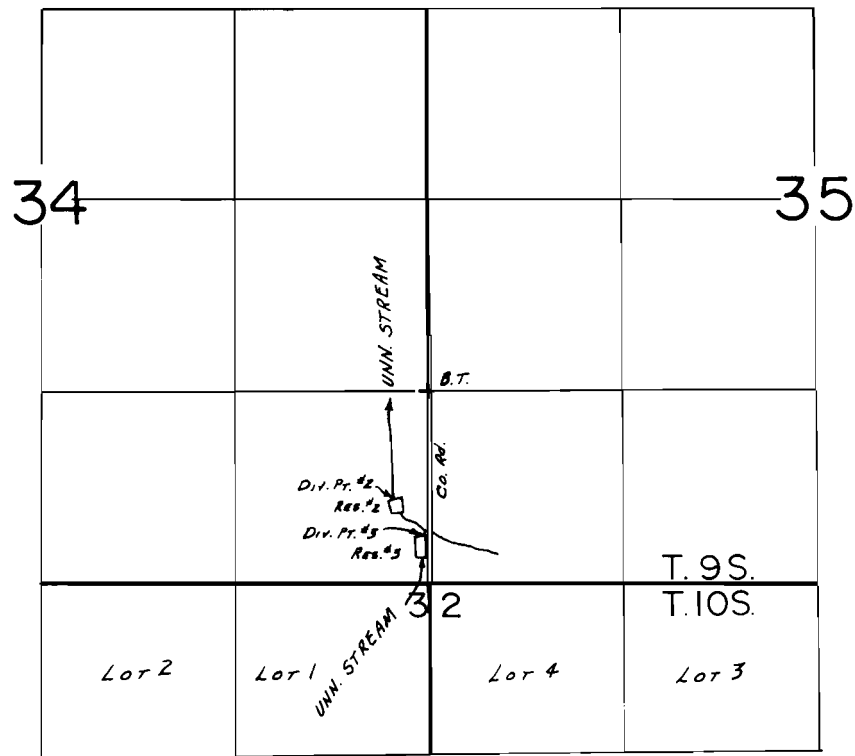

DIV. PT. LOC: #2- 740'S. & 250'W.; #3- 1000'S. & 50'W., BOTH FROM NE COR. SE 1/4 SE 1/4, SEC. 34.

FINAL PROOF SURVEY
UNDER

R-55500 R-6655
Application No. 55501 Permit No. 41996
IN NAME OF

ROSALIND E. & WILLARD M. HOWELL

Surveyed APR. 29, 1980, by S.C. BROWN