


T.20S., R.46E., W.M.



T.20S.
T.21S.

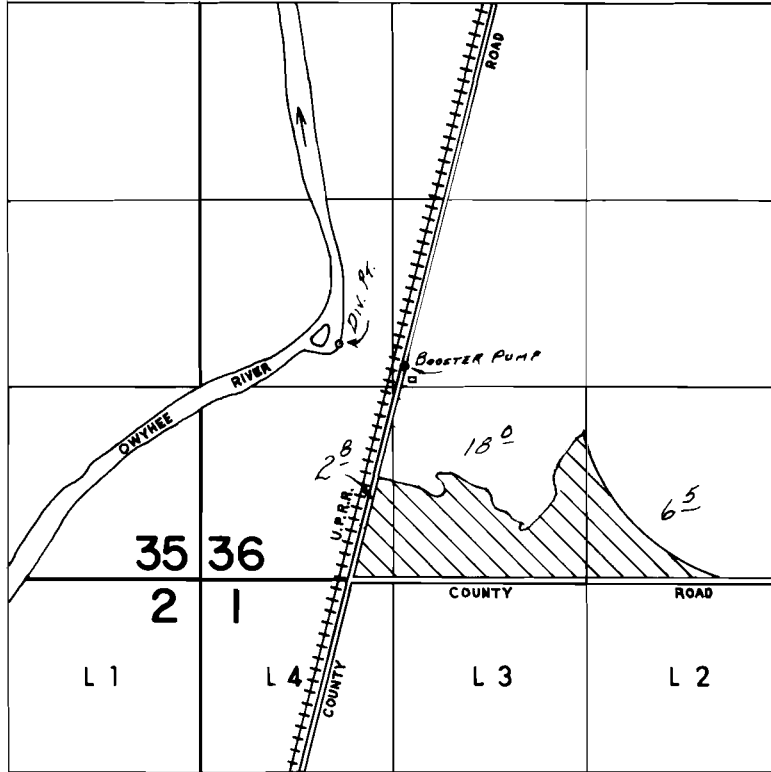

DIV. PT LOC: 1600' N & 950' E. FROM SW COR. SECTION 36.

SCALE: 1"=1,320'

FINAL PROOF SURVEY UNDER

Application No. 55685..... Permit No. 43220.....
IN NAME OF

.....ANDREWS SEED, INC.....

Surveyed MARCH 31, 1986.., by J.M. TOLL.....

REVISED 11/13/88 BUB

41045-478-24R D.C.