


T.36.S., R.3 W., W.M.

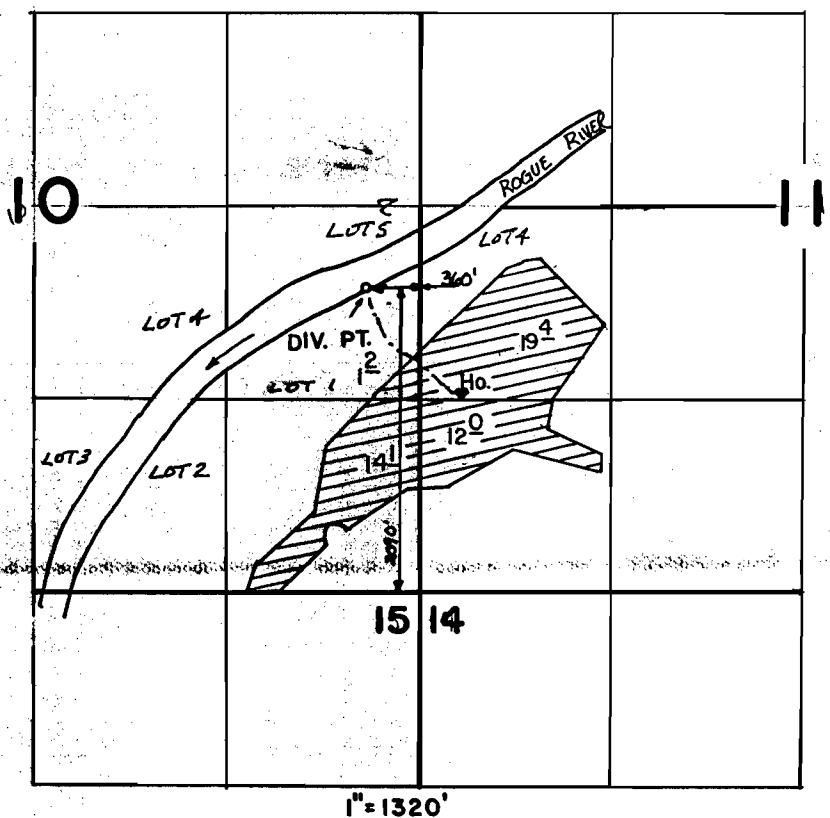

**FINAL PROOF SURVEY
UNDER**

Application No. 55853 41900
61904 Permit No. 45888.....

IN NAME OF

RICHARD OR ROBERT HALDEMAN

Surveyed JUNE 8, 1983, by B.S. JAMES.....