


T. 4S., R. 39E., W. M.

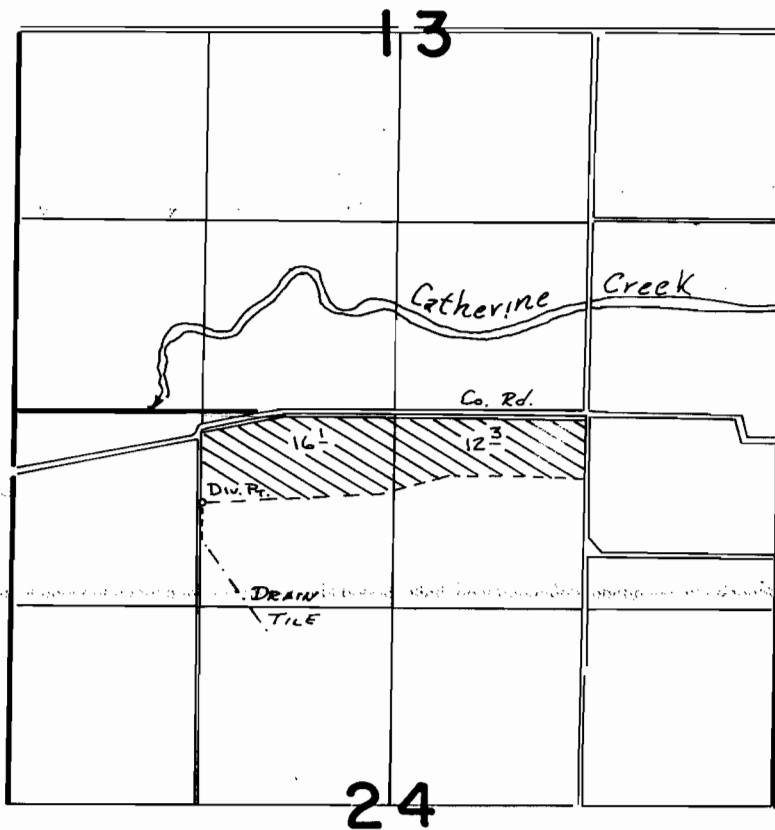

SCALE 1" = 1320'

Div. Pt. Loc: 630'S. & 1320'E. FROM NW COR. SEC. 24

FINAL PROOF SURVEY
UNDER

Application No. **56011**... Permit No. **43256**..
IN NAME OF

EASTERN...ORE...AGRICULTURAL...RES. CENTER

Surveyed ..7..12..... 1984, by *V.L. Church*.....