


T. 5S., R. 40E., W. M.

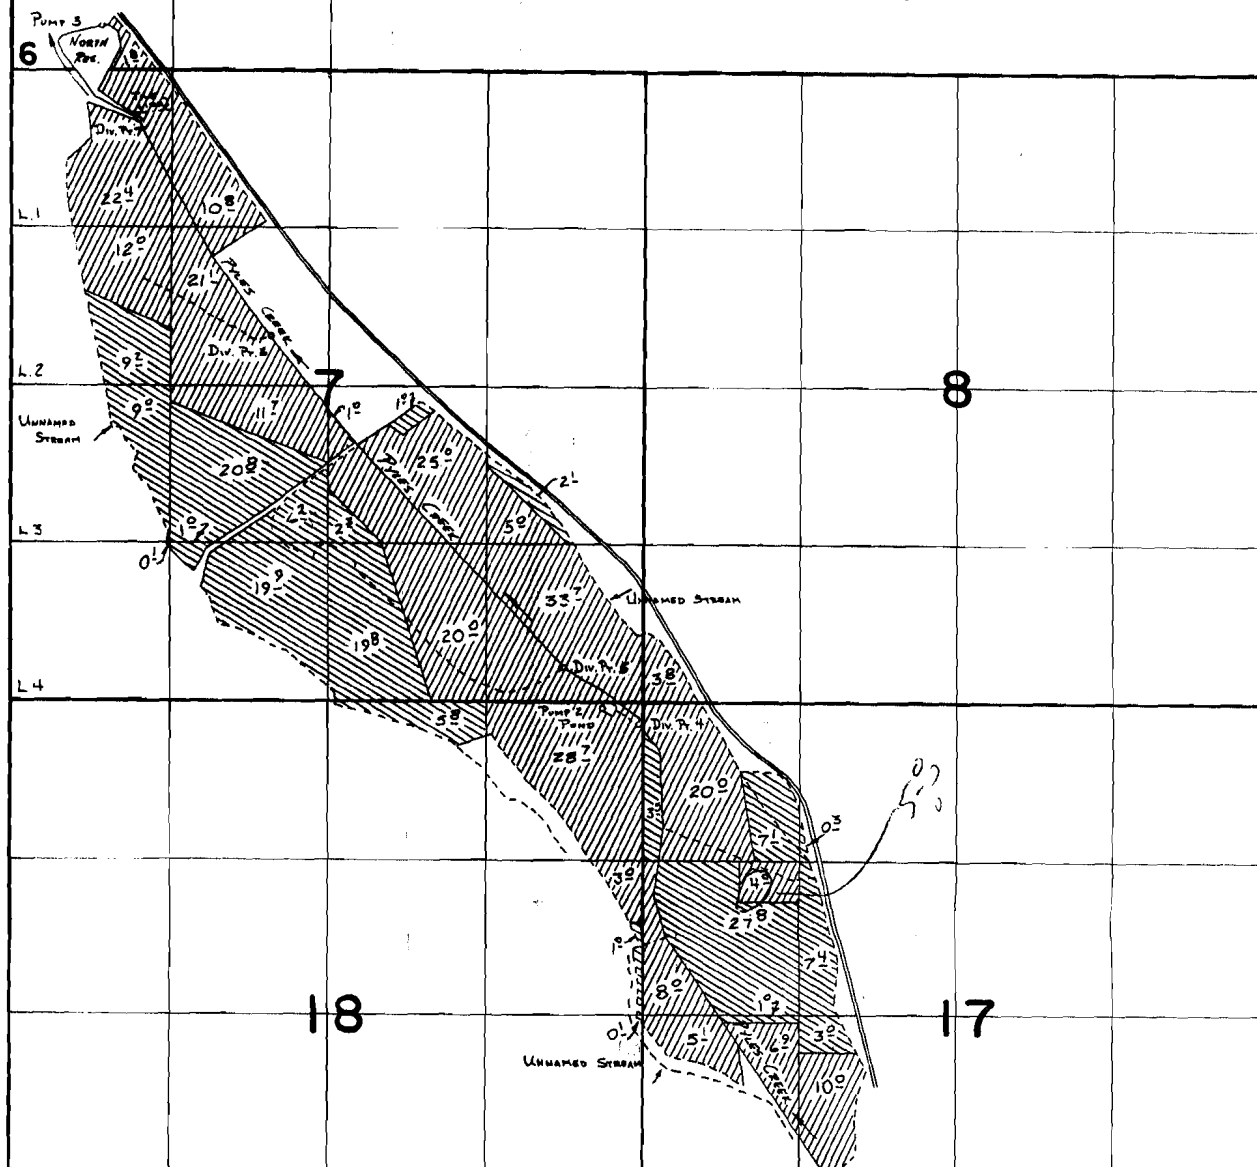

SCALE 1" = 40'

-  PRIMARY PER. 42180
-  PRIM. PER. 4218 SUPPL. PER. 421
-  SUPPL. PER. 42179

PUMP 1 LOCATED 1380'S. & 450'E. FROM N 1/4 COR. SECTION 20
 PUMP 2 50'S. & 350'W. FROM NE COR. SECTION 18
 PUMP 3 380'N. & 750'E. FROM SW COR. SECTION 6
 Div. Pr. 1 LOCATED 1880'S. & 1550'E. FROM N 1/4 COR. SECTION 20
 Div. Pr. 2 640'N. & 580'W. FROM S 1/4 COR. SECTION 17
 Div. Pr. 3 1250'N. & 1060'W. FROM S 1/4 COR. SECTION 17
 Div. Pr. 4 170'N. & 40'W. FROM NE COR. SECTION 18
 Div. Pr. 5 290'N. & 660'W. FROM SE COR. SECTION 7
 Div. Pr. 6 2220'S. & 2180'E. FROM NW COR. SECTION 7
 Div. Pr. 7 410'S. & 1070'E. FROM NW COR. SECTION 7

FINAL PROOF SURVEY UNDER

APPL. R-55033 PER. R-6682
 55079 42180
 R-56255 R-6733
 56579 42179

IN NAME OF

PYLES CANYON CATTLE CO.

Surveyed July 22-24 1985, by V.L. Church

