


T. 5S., R. 40E., W. M.

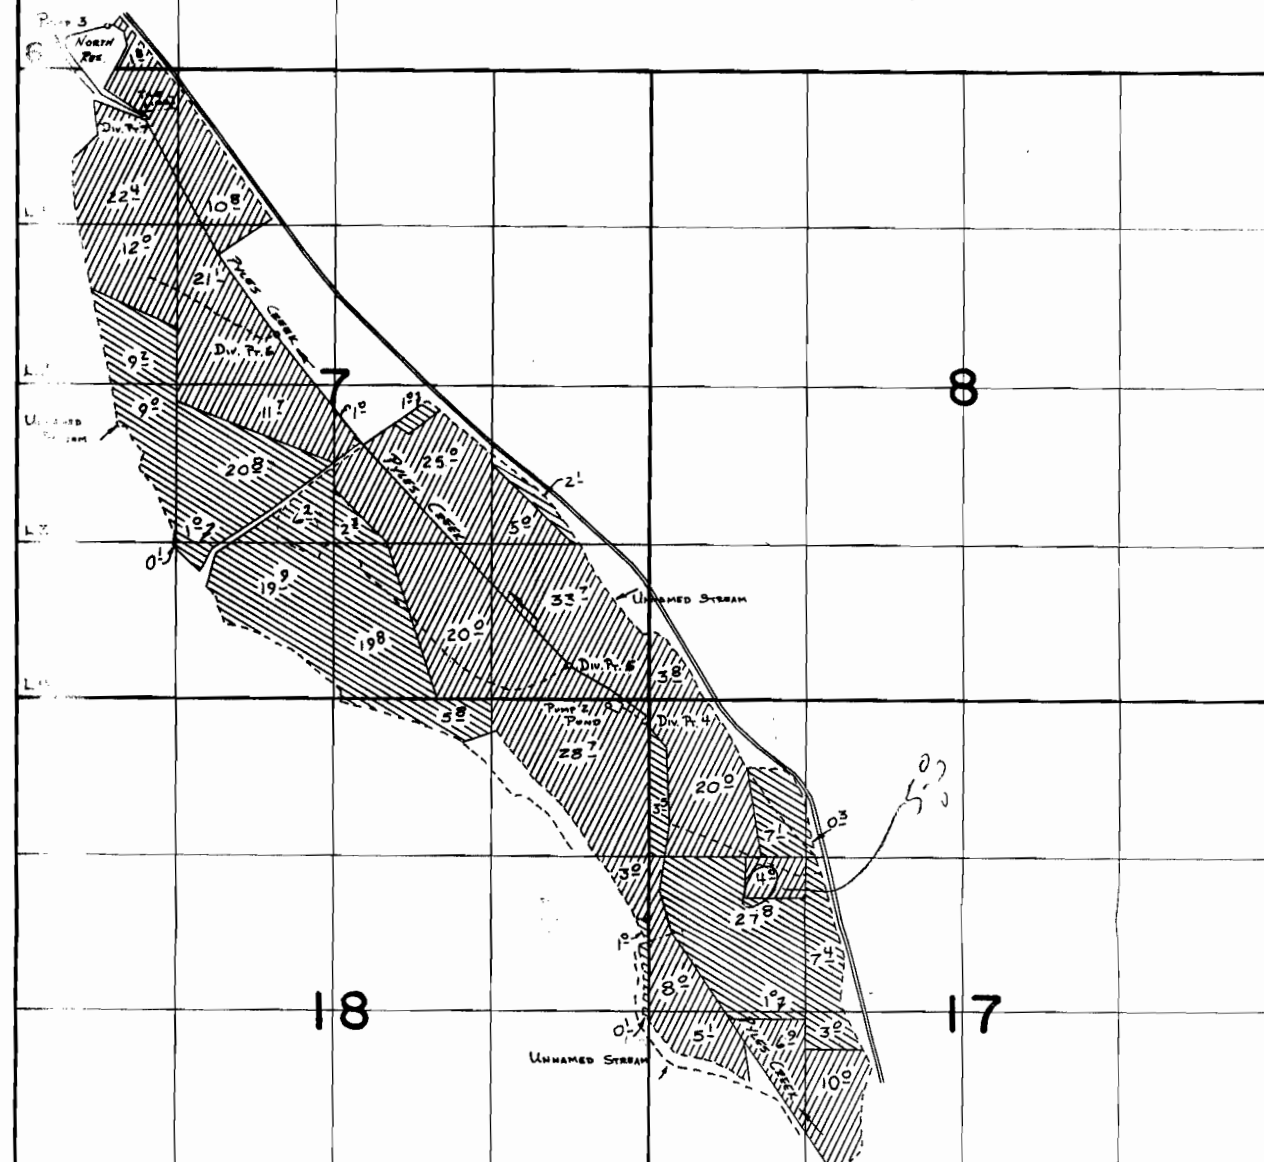

SCALE: 1" = 100'

 PRIMARY
PER. 42180

 PRIM. PER. 4218
SUPPL PER. 421

 SUPPL
PER. 42179 "

PUMP 1 LOCATED 1380'S. & 450'E FROM NW 1/4 COR. SECTION 20
PUMP 2 50'S. & 350'W. FROM NE COR. SECTION 18
PUMP 3 380'N. & 750'E. FROM SW COR. SECTION 6


Div. Pr. 1 Located 1880'S & 1550'E. FROM N¼ COR. SECTION 20
 Div. Pr. 2 640'N. & 580'W. FROM S¼ COR. SECTION 17
 Div. Pr. 3 1250'N. & 1060'W. FROM S¼ COR. SECTION 17
 Div. Pr. 4 170'N. & 40'W. FROM NE COR. SECTION 18
 Div. Pr. 5 290'N. & 660'W. FROM SE COR. SECTION 7
 Div. Pr. 6 2220'S. & 2180'E. FROM NW COR. SECTION 7
 Div. Pr. 7 410'S. & 1070'E. FROM NW COR. SECTION 7

FINAL PROOF SURVEY
UNDER

APPL. R-55033 PER. R-6682
55079 42180
R-56255 R-6733
56579 42179

IN NAME OF

PYLES CANYON CATTLE CO.

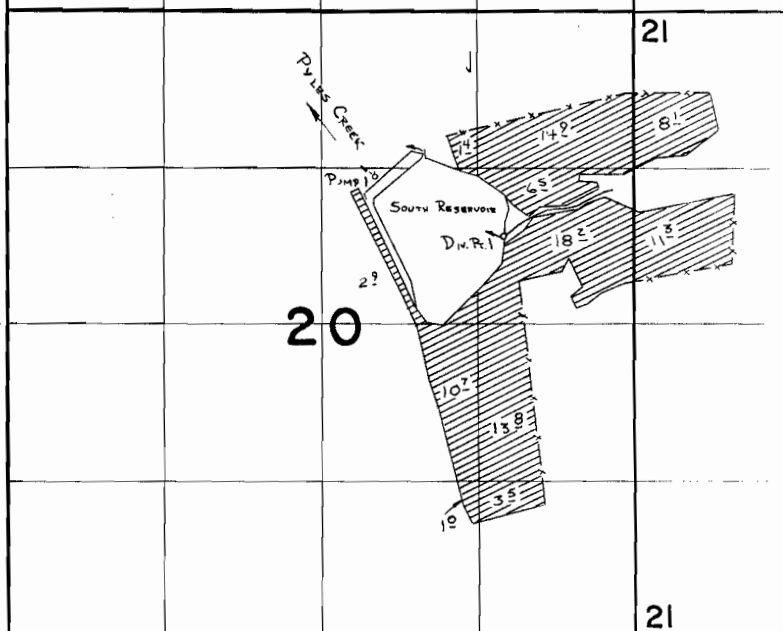

Surveyed July 22-24 1985, by V.L. Church