


T. 36 S., R. 5 W., W. M.

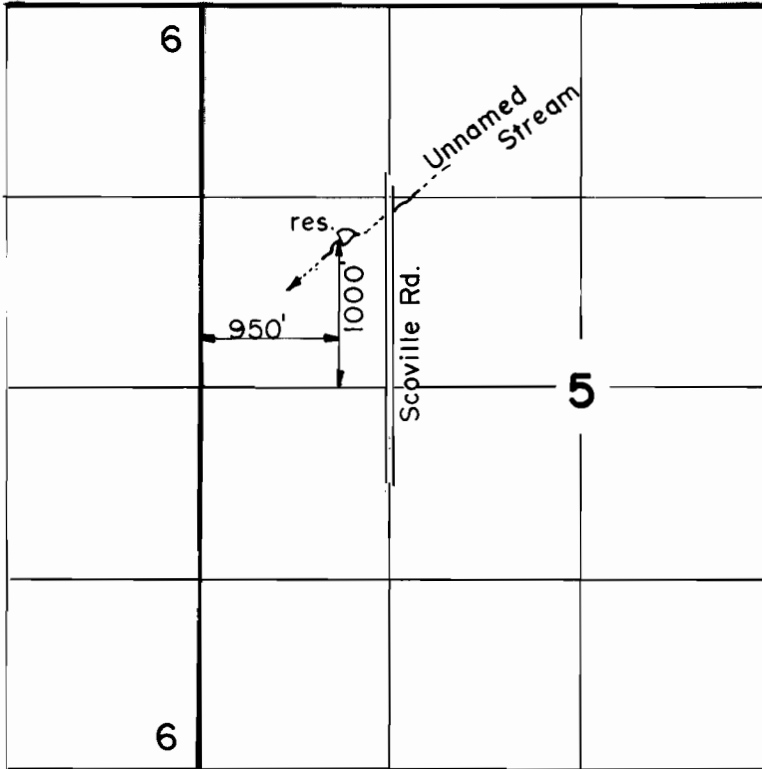

Scale: 1" = 1320'

FINAL PROOF SURVEY
UNDER

R-56700 R-6768
Application No. 56701 Permit No. 42658

IN NAME OF

.....BARBARA B. BERNHART.....

Surveyed JUL...30. 19.87., by B...S...JAMES...