
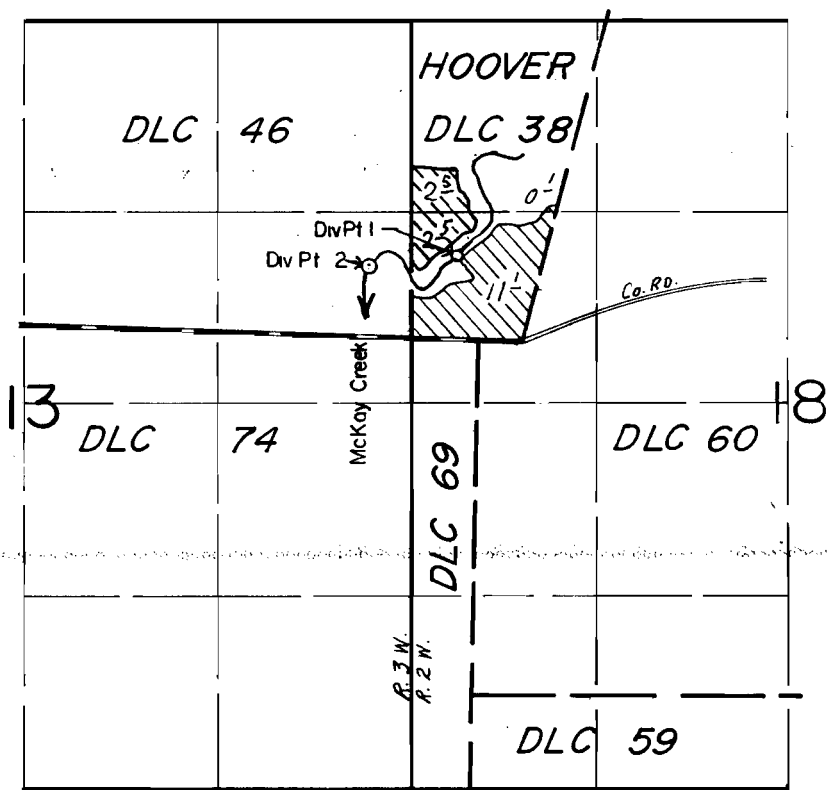


T.1N., R.2&3W., W.M.

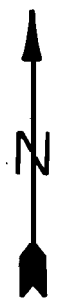

Div Pt 1 Loc 590' N & 450' W, Div Pt 2 Loc 490' N & 1050' W, Both From The SE Corner Hoover DLC 38

SCALE: 1" = 1320'

### FINAL PROOF SURVEY UNDER

Application No. 56909.. Permit No. 42700.....  
IN NAME OF

JAMES S. FISHER

Surveyed Aug. 23. 19.84, by B.W. BISHOP.....

Revised 10-31-89  
DFR-2D-94  
DPM  
BWB