



T. 18S., R. 46E., W.M.

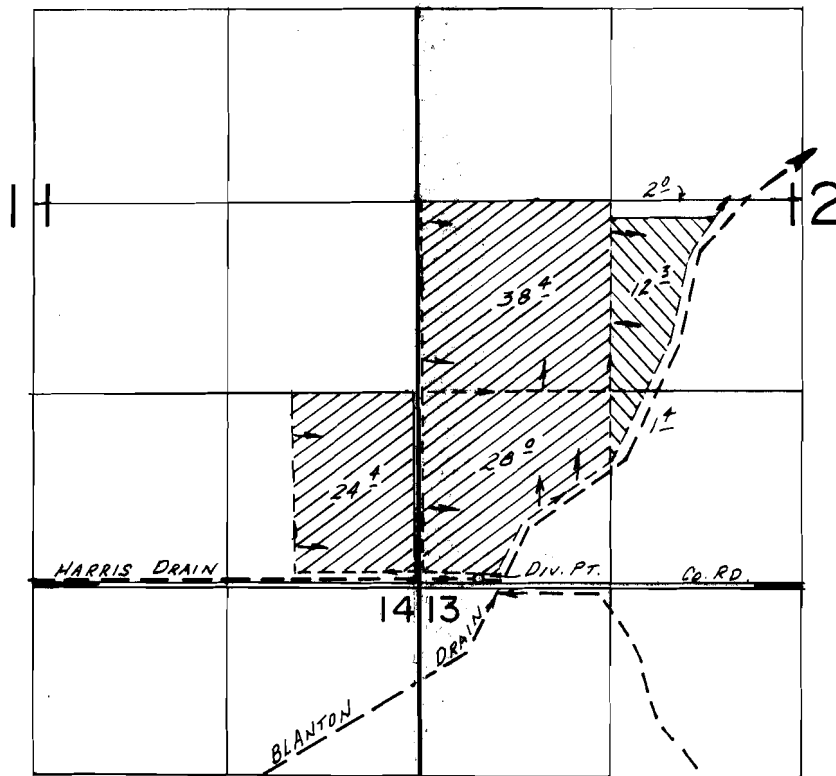

Div. Pt. Loc.: 50' N. & 20' E. FROM SW COR. SEC. 12.

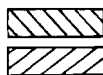

Primary

Supplemental

SCALE: 1" = 1320'

FINAL PROOF SURVEY UNDER

Application No. 56920.. Permit No. 45218.....
IN NAME OF

TRENKEL FARMING & LIVESTOCK

Surveyed Mar..3..... 19.86, by L.M.TOLL.....