


T. 18S., R. 46E., W.M.

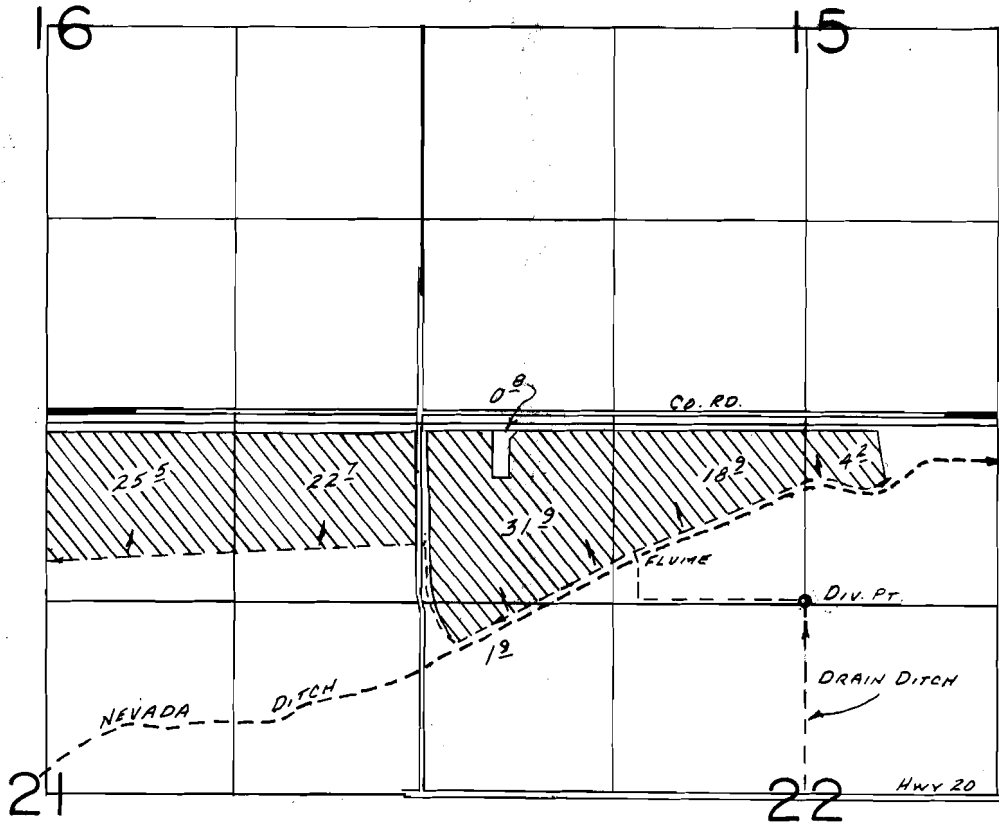

DIV. PT. LOC.: 1300' S. & 2640' E. FROM NW COR. SEC. 22

SCALE: 1" = 1320'

**FINAL PROOF SURVEY**  
UNDER

Application No. 56921... Permit No. 45219.....  
IN NAME OF

.....TRENKEL FARMING & LIVESTOCK

Surveyed Mar. 3..... 19.86, by L.M. TOLL.....

2-19-87 JWB

41045-478-15L