T. 2S., R. 44E., W. M.

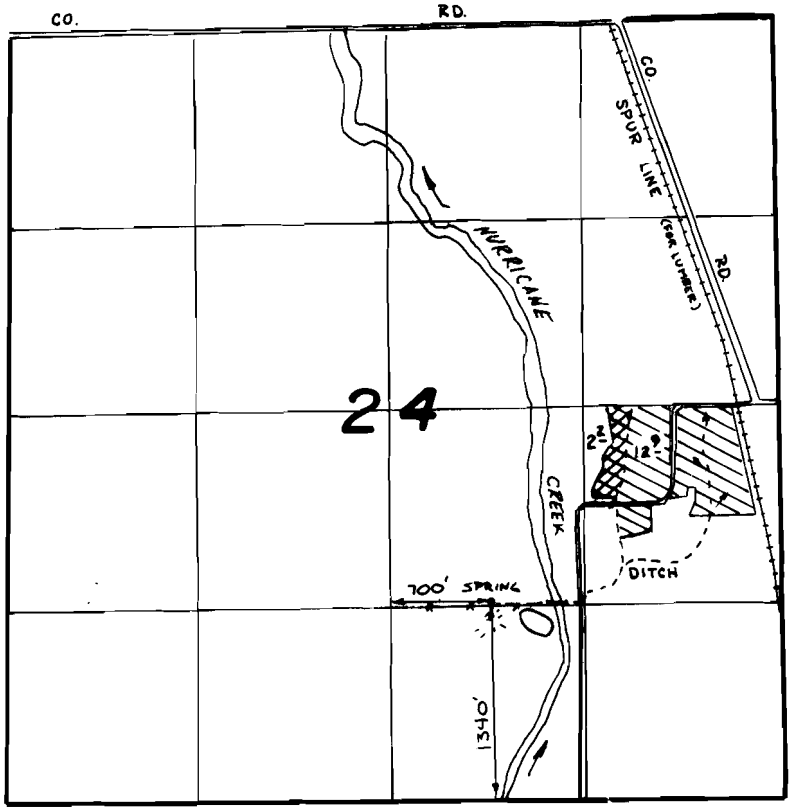

Scale 1" = 1320'

CERT 3181

FINAL PROOF SURVEY
UNDER

Application No. 56933 Permit No. 42788
IN NAME OF

DEAN M. SPRAGUE

Surveyed Aug. 10 19 82., by V. L. Church

1/9/88 VLC
53R 1/9/84