


T. 17S., R. 44E., W.M.

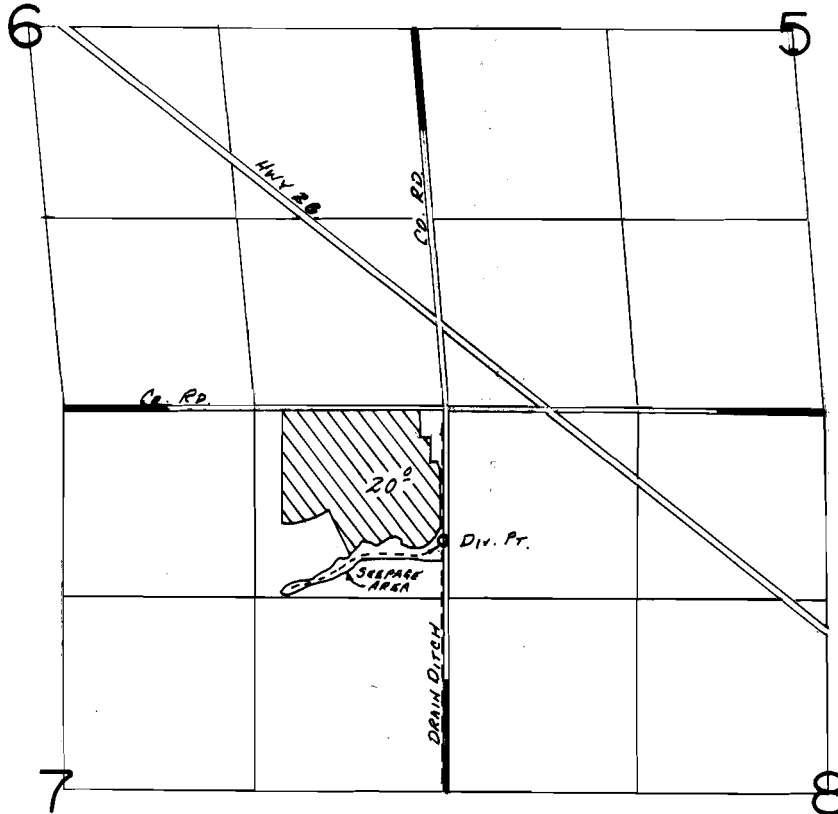

Div. Pt. Loc.: 910's. & 30' W. FROM NE COR. SEC. 7.

SCALE: 1"=1320'

FINAL PROOF SURVEY
UNDER

Application No. 57054. Permit No. 43050...
IN NAME OF

.....EARL C. LAMB.....

Surveyed June 11, 1986, by D. CLARK.....

3/10/87 BMB
41045-478-82R