


# T.28S., R.12 W., W.M.

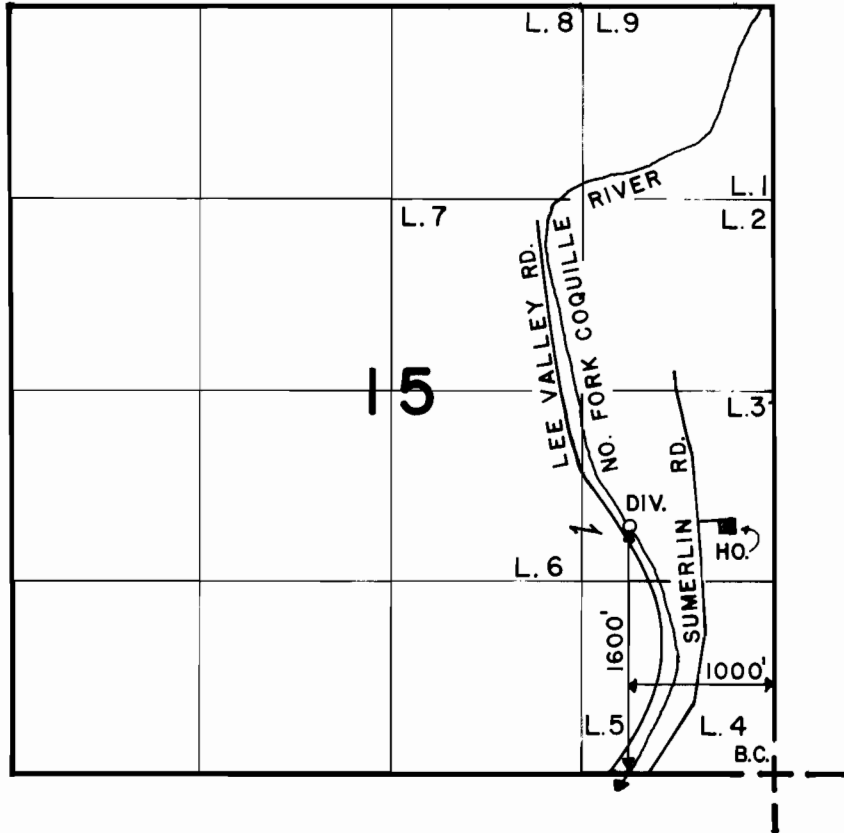

SCALE: 4" = 1 MILE

## FINAL PROOF SURVEY UNDER

Application No. 57208 Permit No. 43021  
IN NAME OF

VERNON J. ALBRIGHT

Surveyed AUG. 27 1985, by J.M. SCHMORDE