


T.5S.,R.3W.,W.M.

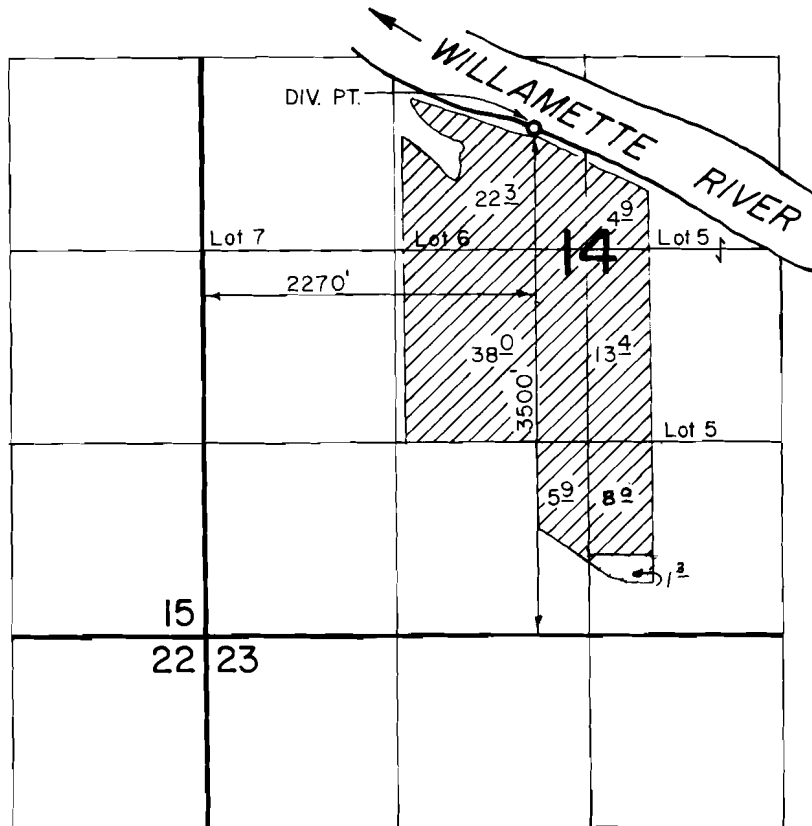

FINAL PROOF SURVEY
UNDER

Application No. 57263 Permit No. 43083
IN NAME OF

NOBLE FARMS

Surveyed MAY 30, 1980, by *W. H. Brown*