


# T.24S., R.7 W., W.M.

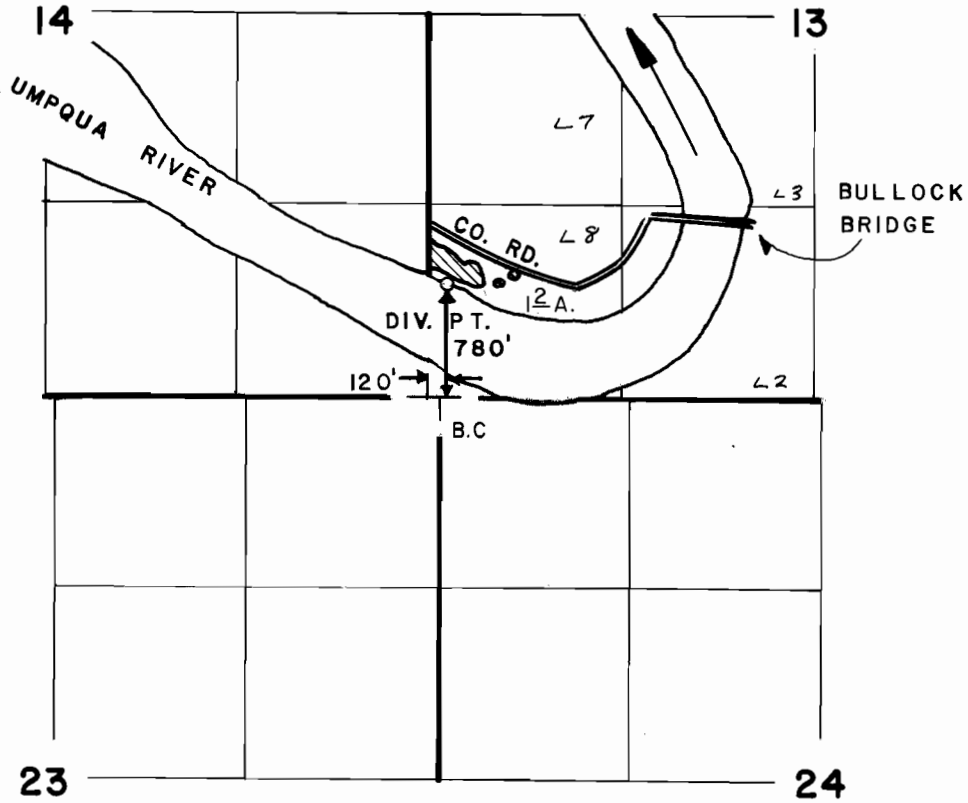

SCALE: 4" = 1 Mile

## FINAL PROOF SURVEY UNDER

Application No. 57305 Permit No. 43123  
IN NAME OF

**MARVIN D. & DORIS F. STEINBACH**

Surveyed AUG. 9 1986, by J. M. SCHMORDE