




T. 38 S., R. 9 E., W.M.

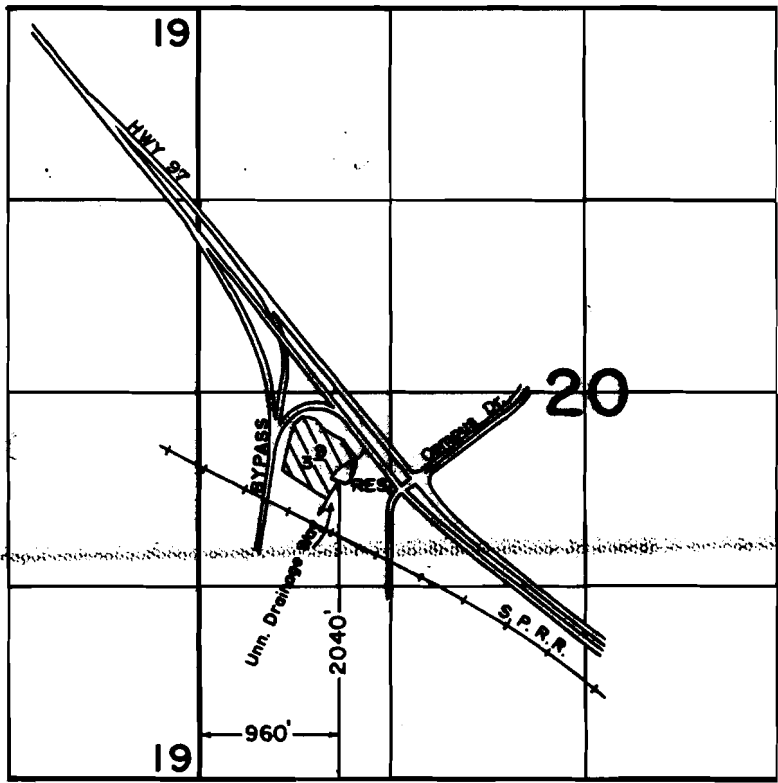

SCALE: 1" = 1320'

FINAL PROOF SURVEY
UNDER

R-57329 R-7737
Application No. 57330... Permit No. 43661.....
IN NAME OF

.....**BRUCE A. FROEMKE**.....

Surveyed **JUNE 16, 1989**, by **B.W. BISHOP**.....