


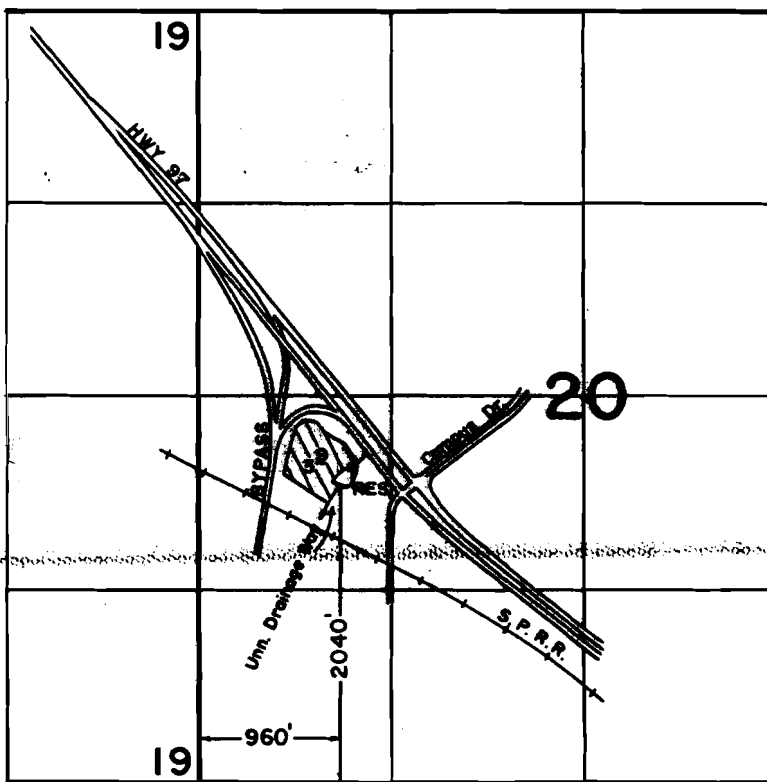

T. 38 S., R. 9 E., W.M.



SCALE: 1" = 1320'

**FINAL PROOF SURVEY**  
UNDER

R-57329                      R-7737

Application No. 57330... Permit No. 43661.....

IN NAME OF

**BRUCE A. FROEMKE**

Surveyed JUNE 16, 1989, by B. W. BISHOP.....

