


43098

64493

64492

T. 3S., R. 26E., W.M.

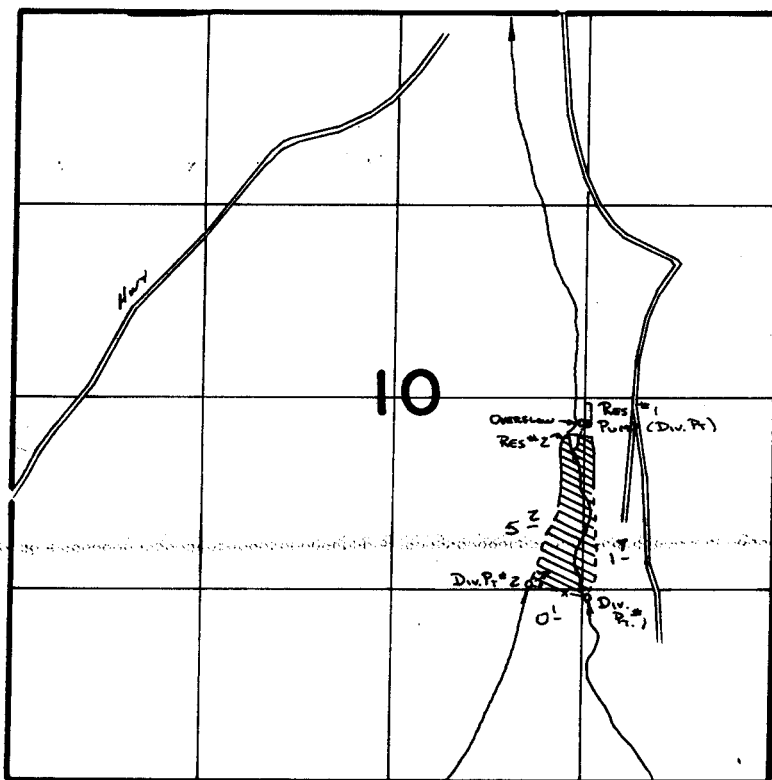

SCALE 1" = 1320'

Pump (Div. Pt.) Loc: 180'S. & 1340'E }
 Div. Pt. #1 Loc: 1370'S. & 1350'E. } FROM CENTER COR. SEC 10
 Div. Pt. #2 Loc: 1280'S. & 950'E }

FINAL PROOF SURVEY UNDER

R-57362 R-7346
 Application No. **57363** Permit No. **43098**..
 IN NAME OF

.....**W. SCOTT MCDANIEL**.....

Surveyed 10-23..... 1982., by **V.L. Church**.....

41649-472-114
 41649-279-1732

VLC