


43098
64493
64492

T. 3S., R. 26E., W.M.

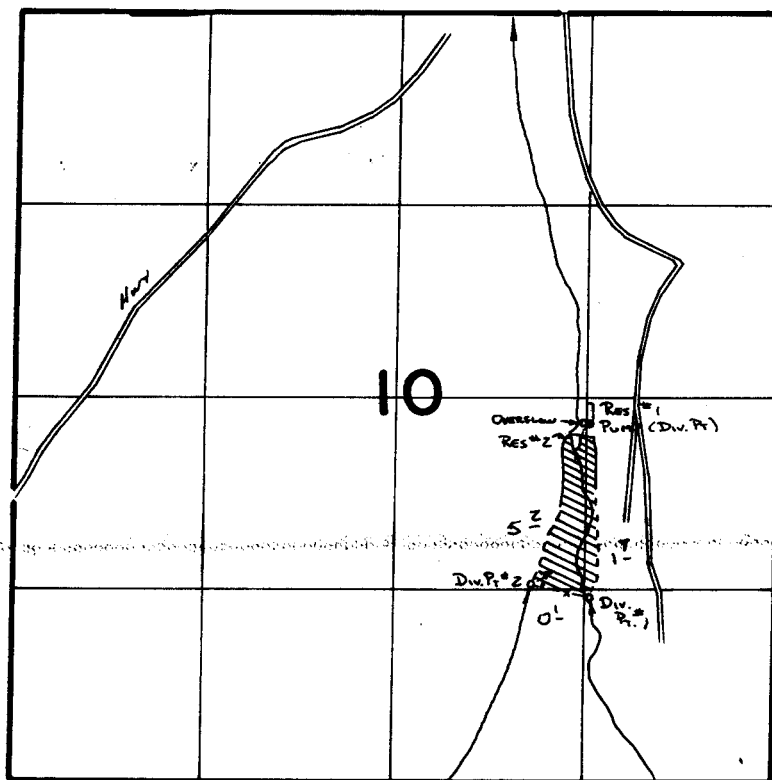

SCALE 1" = 1320'

Pump (Div. Pt.) Loc: 180'S. & 1340'E }
 Div. Pt. #1 Loc: 1370'S. & 1350'E } FROM CENTER COR. SEC 10
 Div. Pt. #2 Loc: 1280'S. & 950'E }

FINAL PROOF SURVEY

UNDER

R-57362 R-7346
 Application No. 57363 Permit No. 43098..
 IN NAME OF

.....W. SCOTT MCDANIEL.....

Surveyed 10-23..... 1982., by V.L. Church.....

41649-472-114
 41649-279-1732

VLC