


T.17S., R.1W., W.M.

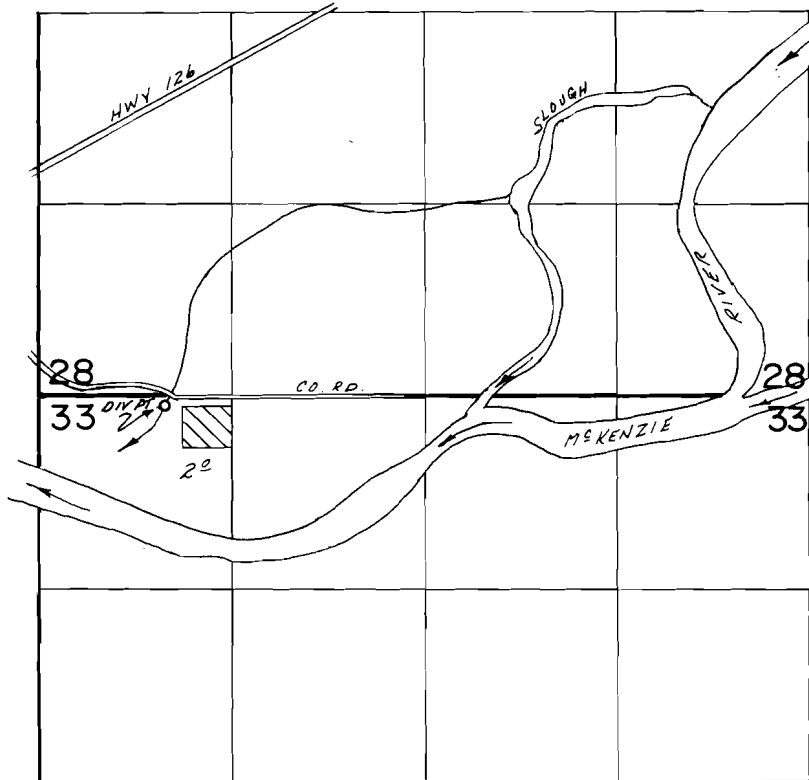

DIV. PT. LOC: 60' S. & 860' E. FROM NW COR. SEC. 33.

SCALE: 1"=1320'

FINAL PROOF SURVEY
UNDER

Application No. 57373. Permit No. 43303.....
IN NAME OF

GLEN A. & CINDY J. CAMPBELL.....

Surveyed Oct. 9..... 19.86, by B.W.BISHOP.....

1-21-87
BWB

DBQ-4JJ-87