


T.7S.,R.1E.,W.M.

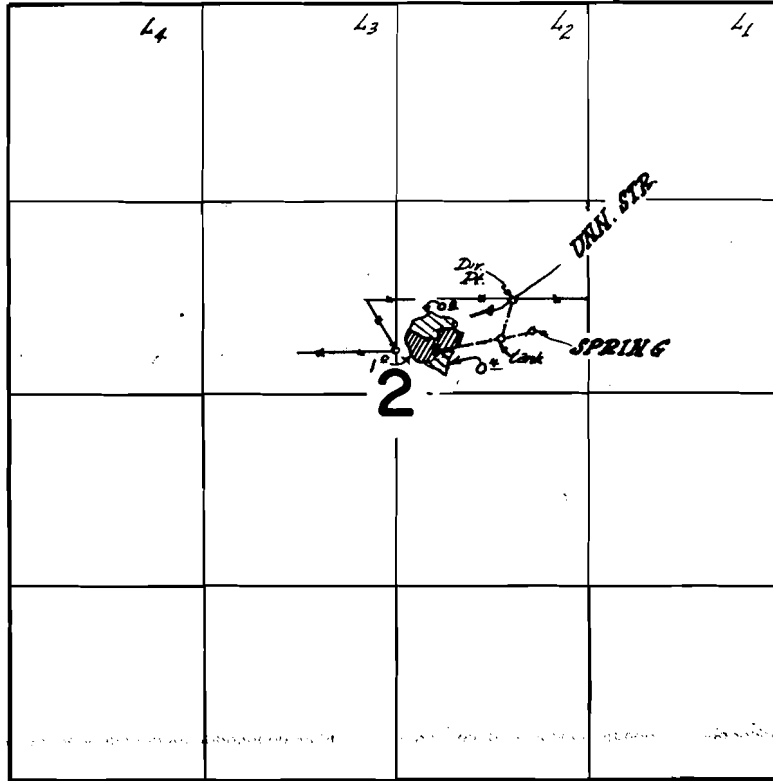


Div. Pts. loc.: Stream - 630' N. & 530' W.; Spring - 430' N. & 390' W.; both from the SE cor. SW 1/4 NE 1/4 Sec. 2.

FINAL PROOF SURVEY UNDER

57492
55113

43232 PRIMARY 
41389 SUPPLEMENTAL 

Application No. 53555 Permit No. 40322 PRIMARY 
IN NAME OF

.....JOHN E. & VIRGINIA A. AGAR.....

Surveyed Sept. 8 1977, by R. G. Muckler
JUNE 13 1984 BEN BISHOP