


# T. 3 S. R. 40 E. W.M.

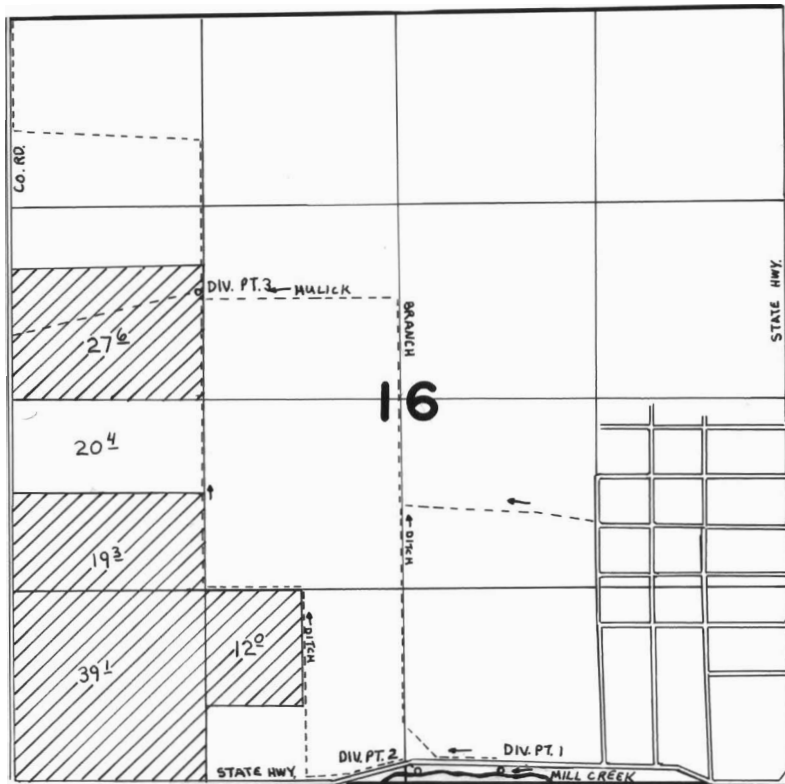

Scale 1"=1320'



- DIV. PT. 1 LOC. 80' N. & 650' E. FROM S. 1/4 COR. SEC. 16
- DIV. PT. 2 LOC. 70' N. & 80' E. FROM S. 1/4 COR. SEC. 16
- DIV. PT. 3 LOC. 730' N. & 1350' W. FROM CENTER COR. SEC. 16

## FINAL PROOF SURVEY UNDER

Application No. 57611.... Permit No. 44319.....  
IN NAME OF

**JERREL W. HARLIEN**

Surveyed July...10.. 1984, by ..V..Church.....