


T.7S.,R.18&2W.,W.M.

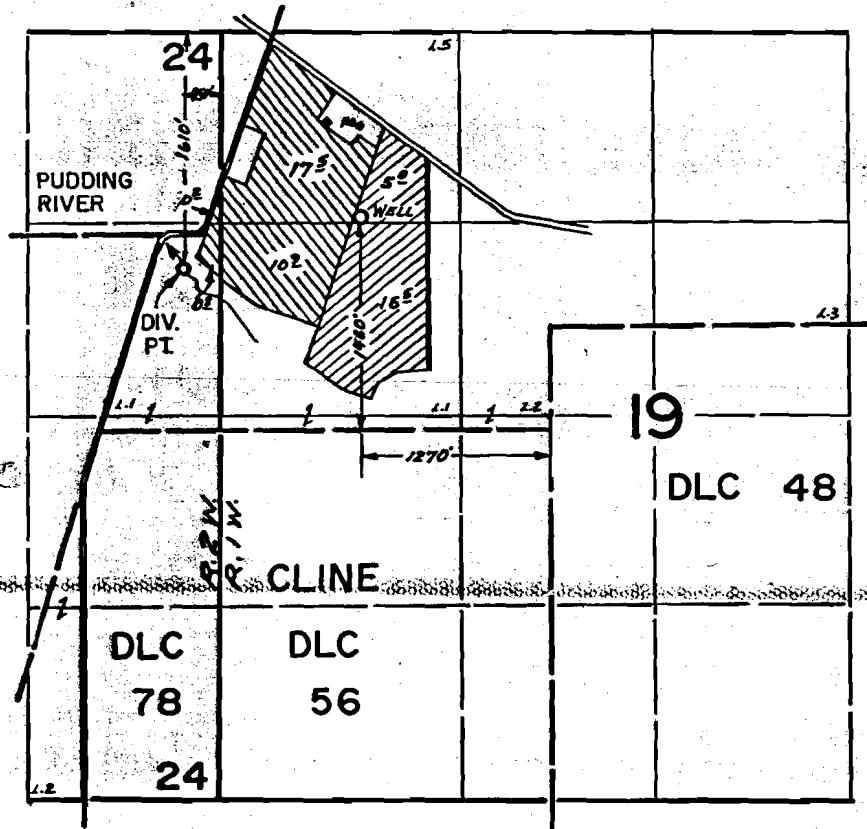

PRIMARY - G-9032, SUPPLEMENTAL-61939

PRIMARY - 57718, SUPPLEMENTAL-G-9032

**FINAL PROOF SURVEY**  
UNDER

G-9032                      G-8391  
57718                      43447

Application No. 61939      Permit No. 46278  
IN NAME OF

**DONALD W. MANTIE**

Surveyed Aug. 13, 1981, by L. TOLL  
Aug. 16, 1985, by B. W. BISHOP