


T.29S. R.6W. W.M.

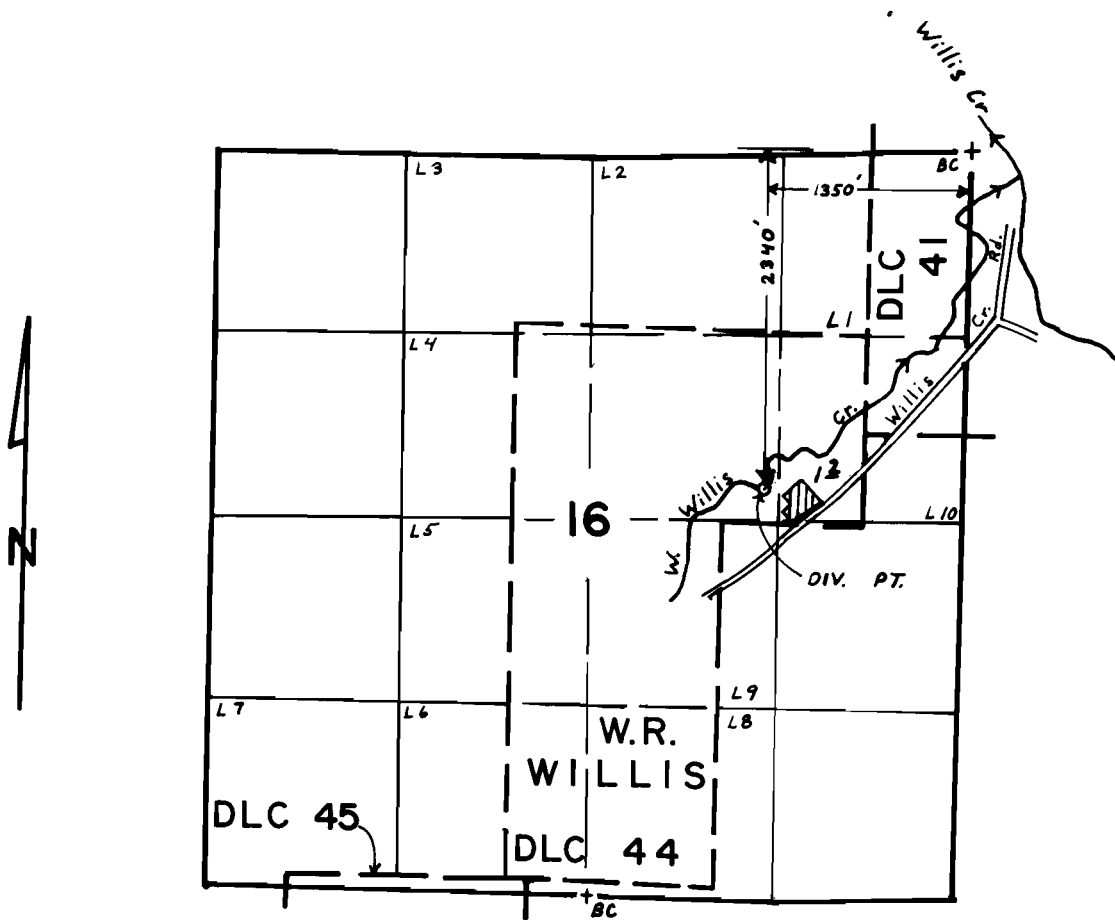

**FINAL PROOF SURVEY**  
UNDER

Application No. 57730. Permit No. 43848...  
IN NAME OF

**M.N. & N.L. GILBERT**

Surveyed JAN. 26 1984, by *L. E. Cashion*