


T. 36 S., R. 6 W., W. M.

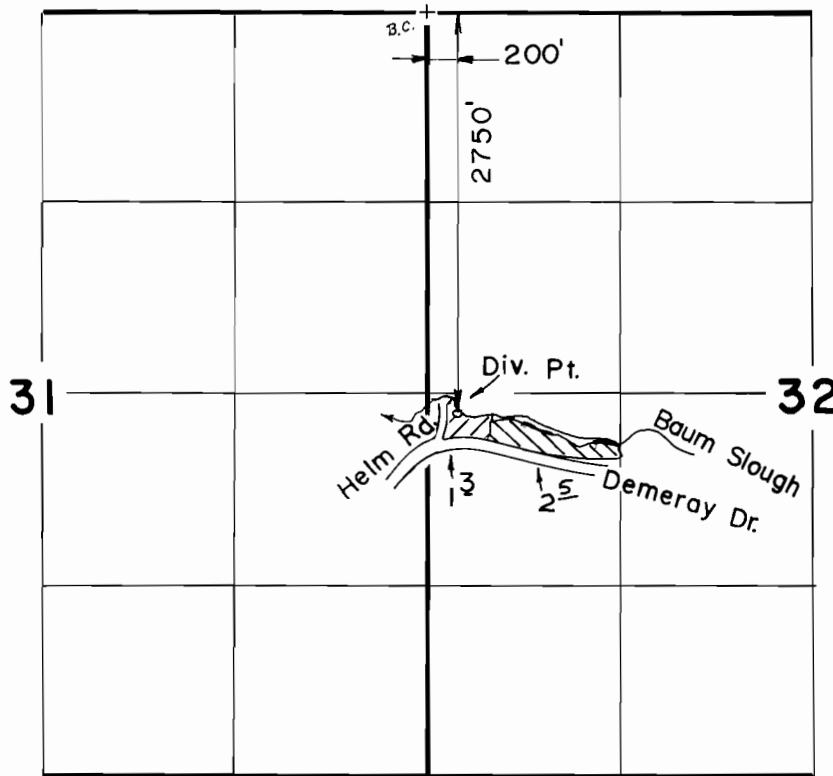

Scale: 1" = 1320'

Primary



Supplemental



FINAL PROOF SURVEY
UNDER

Application No. **57785** Permit No. **43888**
IN NAME OF

RICHARD OLSON

Surveyed Sep. 21, 1987, by B. S. JAMES