


T. 39 S. , R.3W. , W.M.

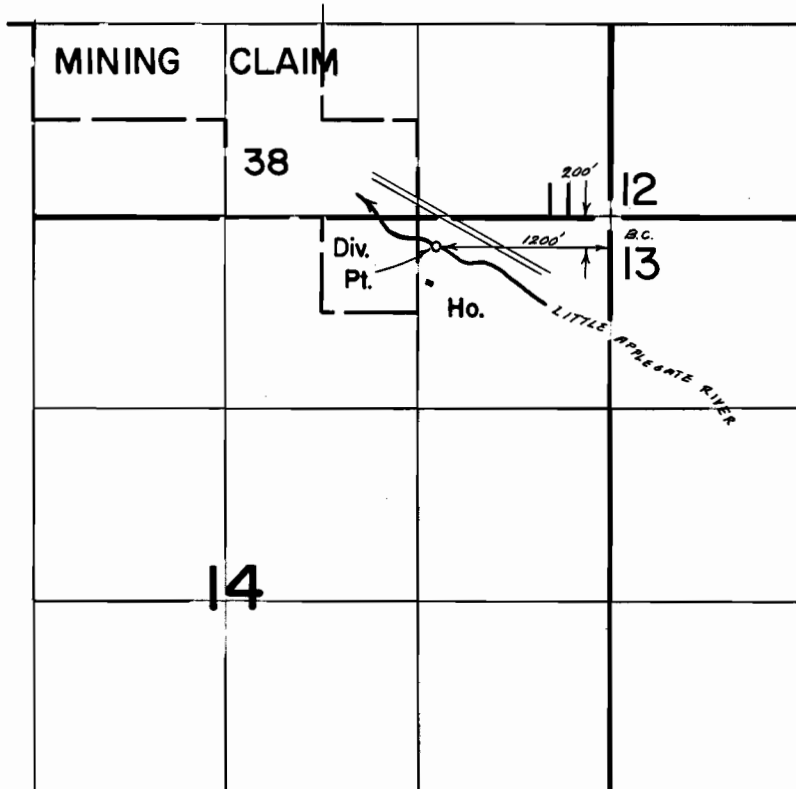

Scale 1" = 1320'

FINAL PROOF SURVEY UNDER

Application No. 57951 Permit No. 43677
IN NAME OF

BARBARA A. FLYNN

Surveyed Nov. 23, 1987, by B.S. JAMES