


T. 2N.R.13E.W.M.

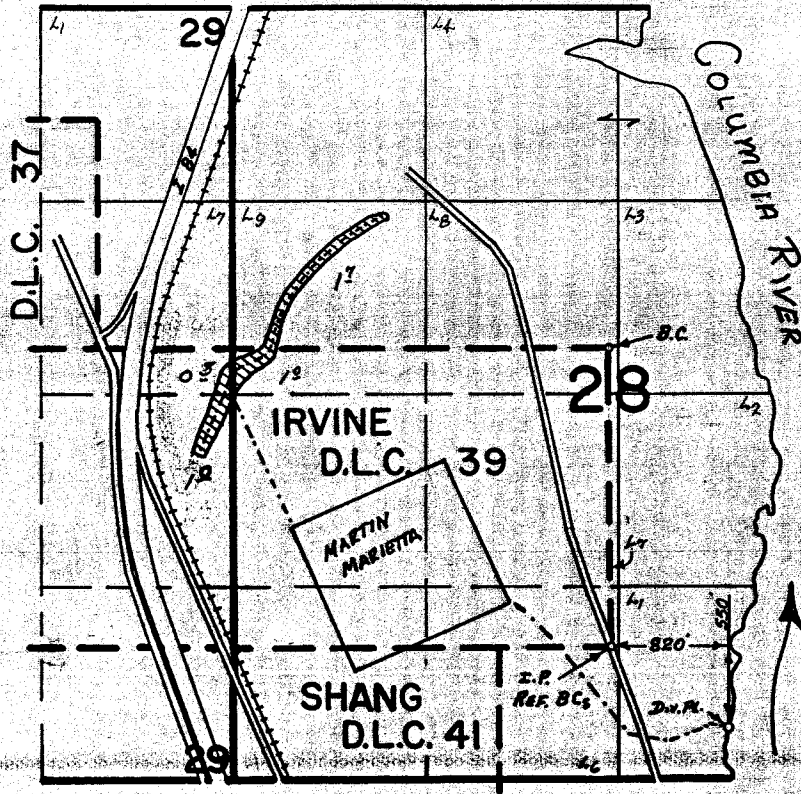

**FINAL PROOF SURVEY**  
UNDER

Application No. 58051 Permit No. 44001  
IN NAME OF

MARTIN MARIETTA

Surveyed Sept. 26 1983, by T.J. Paul