


# T.4S., R.1W. & IE., W.M.

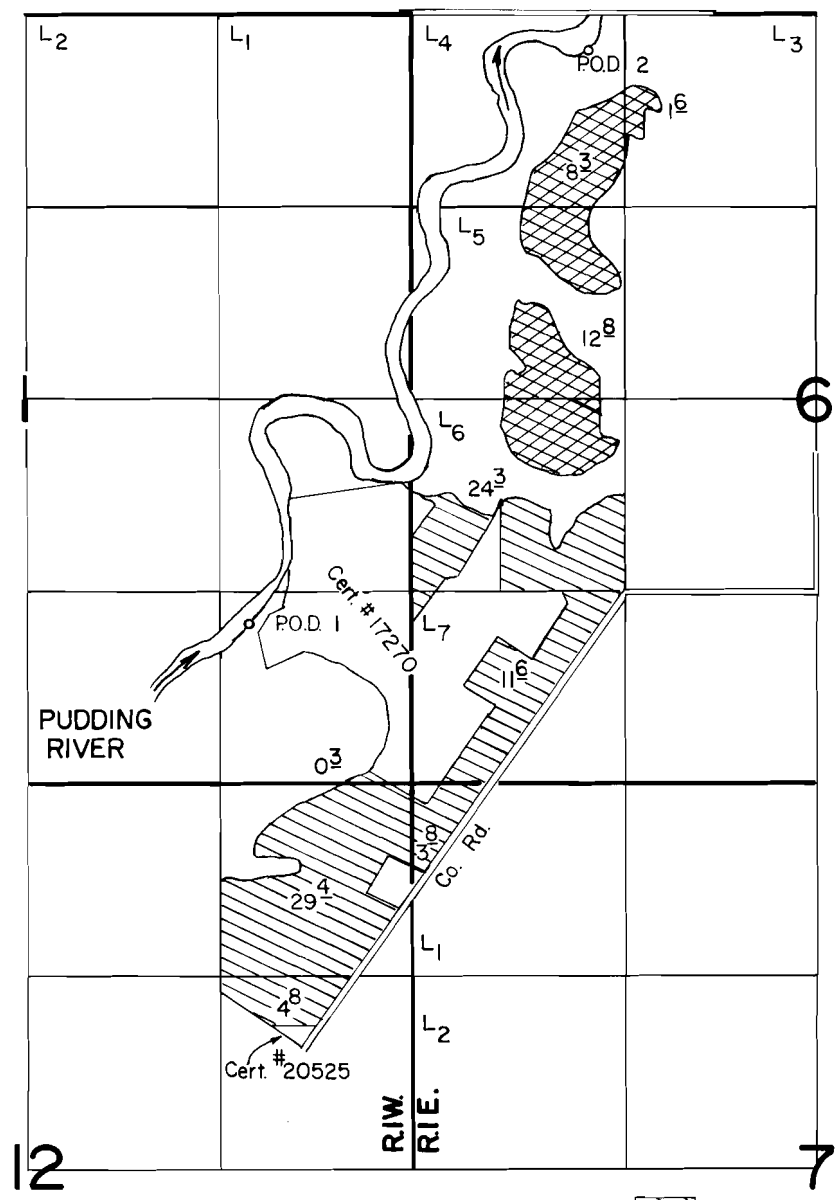

Scale: 1" = 1320'



- P.O.D. 1 Loc.: 1090' N. & 1100' W. from SE Cor. Sec. 1, T.4S., R.1W., W.M.
- P.O.D. 2 Loc.: 260' S. & 1220' E. from NW Cor. Sec. 6, T.4S., R.1E., W.M.

## FINAL PROOF SURVEY UNDER

Application No. 58215... Permit No. 43863.....  
IN NAME OF

**RICHARD E. ANDERSON**

Surveyed JULY 2... 1986., by T. Warren.....